

Jackson
 \$ 2089.
 11/14/77

MISSISSIPPI
 BOARD OF WATER COMMISSIONERS
 416 North State Street
 Jackson, Mississippi 39201

WATER WELL DRILLERS LOG

11-14 1977 Coast Water Well Sew. Jackson
 date well completed firm name county well located

LANDOWNER	Description of formations encountered	from	to
1402 Apache St. Pascagoula, Miss. (mailing address) 39567	Top soil	0	1
	Sand (m)	1	8
WELL LOCATION: sec. 32 T 7 S R 7 W 6 miles East of Ocean Springs (distance) (direction) (nearest town)	Blue Clay	8	53
	Sand Gravel	53	74
WELL PURPOSE: Home (home, irrigation, municipal, industrial)	Blue Clay	74	90
WELL COMPLETION DATA:	Sand (m)	90	120
(1) diameter (inches) 2"	Sand (m)	120	150
(2) total depth (feet) 302'	Blue Clay	150	270
(3) static water level (feet) 40' below top of ground.	Sand (m)	270	302
(4) casing P.V.C. 292' (material) (depth) 2" (size) if telescope see back.			
(5) screen 10' 292' (length) (depth to top) 2" P.V.C. (size) (material)			
(6) pump 1/2 HP 9 (HP) (yield gpm) Elect. (type power)			
(7) electric log No (yes or no) (organization running log)			
(8) how well bottom plugged back wash valve			
DRILLERS REMARKS:			


RECEIVED

JAN 17 1978

MISS. Bd. OF WATER COMMISSIONERS

If well telescopes please sketch and show depths.

GROUND LEVEL

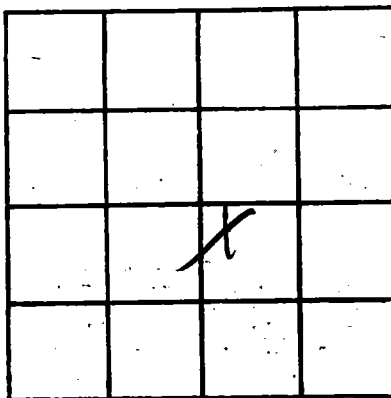

SECTION 32

Please indicate well location X.

ADDITIONAL INFORMATION

If more than one screen, show locations of each on sketch.