

Jackson
 2061
 12/12/77

MISSISSIPPI
 BOARD OF WATER COMMISSIONERS
 416 North State Street
 Jackson, Mississippi 39201

WATER WELL DRILLERS LOG

12-12-77 date well completed
 1977 Coach Water Well Sew. firm name
 Jackson county well located

LANDOWNER	description of formations encountered	from	to
Allen E. Eberka	Top soil	0	1
Rt 6 - Box 143 D.D.	Sand (m)	1	8
Ocean Springs, Miss. (mailing address) 37564	Grey Clay	8	64
	Sand (c)	64	100
	Blue Clay	100	194
	Sand (m)	194	215

WELL LOCATION:
 sec. 17 T. 7 N. R. 7 E.
 6 miles N. West of Gautier
 (distance) (direction) (nearest town)

WELL PURPOSE: Home
 (home, irrigation, municipal, industrial)

- WELL COMPLETION DATA:
- (1) diameter (inches) 2"
 - (2) total depth (feet) 215'
 - (3) static water level (feet) 25' below top of ground.
 - (4) casing PVC, 205' (material) (depth)
 2" (size) if telescope see back.
 - (5) screen 10' (length), 205' (depth to top)
 2" (size), PVC (material)
 - (6) pump 1 hp (HP), 10 (yield gpm)
 Elec (type power)
 - (7) electric log No. (yes or no)
 - (8) how well bottom plugged Back wash Valve

DRILLERS REMARKS:


RECEIVED

JAN 17 1978

MISS. BD. OF WATER COMM.

If well telescopes please sketch and show depths.

GROUND LEVEL

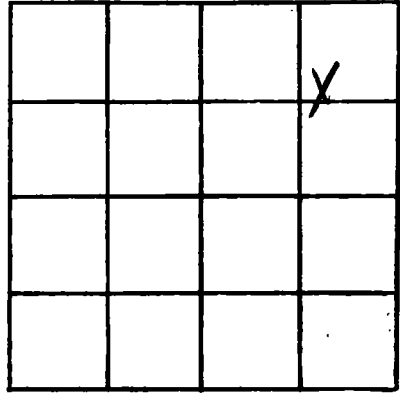

SECTION 17

Please indicate well location X.

ADDITIONAL INFORMATION

If more than one screen,
show locations of each on sketch.