

Jackson
 # 2062
 12/21/77

MISSISSIPPI
 BOARD OF WATER COMMISSIONERS
 416 North State Street
 Jackson, Mississippi 39201

WATER WELL DRILLERS LOG

12/21/77 19 date well completed
 Coastal Drilling firm name
 Jackson county well located

LANDOWNER: W.W. Wilton
Ocean Springs, Miss
 (mailing address)

description of formations encountered	from	to
top soil	1	3
slight sand	3	15
soft blue clay	15	30
blue white sand	30	64

WELL LOCATION:
 sec. 7 T. 8 N. R. 8 E.
1/2 mile south of N.R.R.
 (distance) (direction) (nearest town)

WELL PURPOSE: home
 (home, irrigation, municipal, industrial)

- WELL COMPLETION DATA:
- (1) diameter (inches) 2"
 - (2) total depth (feet) 64'
 - (3) static water level (feet) 6' below top of ground.
 - (4) casing PVC 59' (material) (depth)
 - _____ if telescope see back. (size)
 - (5) screen 5' 59' (length) (depth to top)
 - 2" PVC (size) (material)
 - (6) pump 1/2 12 (HP) (yield gpm)
 - 5 hp (type power)
 - (7) electric log no (yes or no)

(organization running log)

(8) how well bottom plugged
2" lead (weld) pipe


DRILLERS REMARKS:
For heat pump

RECEIVED

JAN 16 1978

If well telescopes please sketch and show depths.

GROUND LEVEL

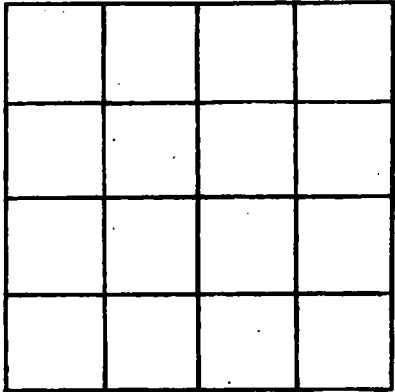

SECTION _____

Please indicate well location X.

ADDITIONAL INFORMATION

A series of 20 horizontal lines for recording additional information.

If more than one screen, show locations of each on sketch.