

JACKSON

02068

MISSISSIPPI BOARD OF WATER COMMISSIONERS
416 North State Street
Jackson, Mississippi 39201

WATER WELL DRILLERS LOG

5-19-78 date well completed 78 Coast Water Well Sew. Inc. firm name Jackson county well located

LANDOWNER: Ray Hawley

P.O. Box 882

Hawley Miss 39153
Property located on Section 5, T. 7 N., R. 7 W., S. 1

WELL LOCATION:

sec 26 T 7 N R 7 W
miles in direction of Hartier (nearest town)

WELL PURPOSE: Home
(home, irrigation, municipal, industrial)

WELL COMPLETION DATA:

- (1) diameter (inches) 2"
- (2) total depth (feet) 263'
- (3) static water level (feet) 10' below top of ground
- (4) casing (material) PVC (depth) 253'
- (5) screen (length) 10' (depth to top) 253'
- (6) pump (HP) 1/2 (yield gpm) 10
- (7) electric log No. (yes or no)

(organization running log)

(8) how well bottom plugged back wash valve

description of formations encountered	from	to
Top soil	0	2
Grey Clay sand	8	35
Grey Clay	35	110
Sand (m)	110	120
Blue Clay	120	160
Sand Gravel (mc)	160	263


RECEIVED
AUG - 3 1978

DRILLERS REMARKS:

MISS. BD. OF WATER COMM.

If well telescopes please sketch and show depths.

GROUND LEVEL

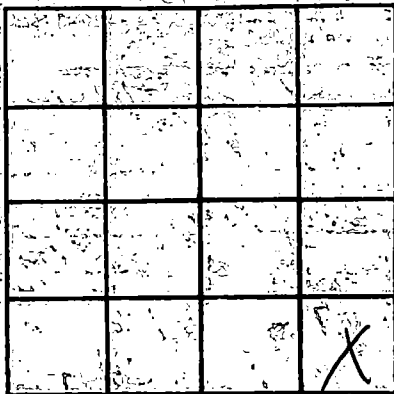

SECTION 26

Please indicate well location X.

ADDITIONAL INFORMATION

If more than one screen, show locations of each on sketch.