

JACKSON
 0 2071
 7-1-78

MISSISSIPPI
 BOARD OF WATER COMMISSIONERS
 416 North State Street
 Jackson, Mississippi 39201

WATER WELL DRILLERS LOG

7-1-78 date well completed 78 Coast Water Well Serv Inc firm name Jackson county well located

LANDOWNER: Dan Laurel
 Rt 7 - Box 272 B -
 Ocean Springs, Miss 3844
 (mailing address)

WELL LOCATION:
 sec 19 T 8 N R 7 E
 7 miles East of Ocean Springs
 (distance) (direction) (nearest town)

WELL PURPOSE: Home
 (home, irrigation, municipal, industrial)

WELL COMPLETION DATA:
 (1) diameter (inches) 2"
 (2) total depth (feet) 500'
 (3) static water level (feet) 40' below top of ground.
 (4) casing PVC 490'
 (material) (depth)
 2" (size) if telescope see back.
 (5) screen 10' 490'
 (length) (depth to top)
 2" PVC (size) (material)
 (6) pump 1 h.p. 8.5
 (HR) (yield gpm)
 Elec. (type power)
 (7) electric log No-
 (yes or no)
 (organization running log)
 (8) has well bottom plugged
 back with blue

description of formations encountered	from	to
Top soil	0	70
Sand (C)		
Blue Clay	70	86
Sand (C)	86	120
Blue Clay	120	377
Sand (MF)	377	387
Blue Clay	387	486
Sand (MC)	486	500


RECEIVED
 NOV - 9 1978

DRILLERS REMARKS:

MISS. BD. OF WATER COMM

If well telescopes please sketch and show depths.

GROUND LEVEL

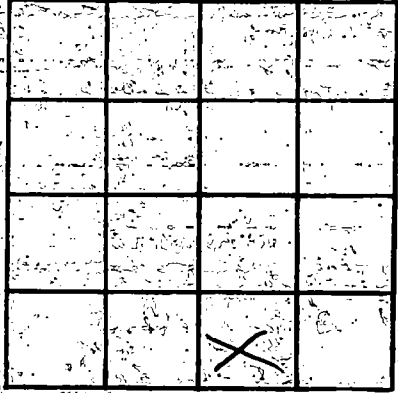

SECTION 19

Please indicate well location X:

ADDITIONAL INFORMATION

If more than one screen, show locations of each on sketch.