

JACKSON

0 2073

8-10-78

MISSISSIPPI BOARD OF WATER COMMISSIONERS 416 North State Street Jackson, Mississippi 39201

WATER WELL DRILLERS LOG

8-10-78 date well completed Past Water Well Sew. Inc firm name Jackson county well located

LANDOWNER

James H Morgan 2405 Duillate Lake Rd Gautier, Miss. 39553 (mailing address)

description of formations encountered

from to

Table with 3 columns: description of formations encountered, from, to. Rows include Top soil (0-5), Red Clay (5-10), Blue Clay (10-39), White coarse sand & shell (39-69), Blue Clay (69-80), Gray coarse sand & shell (80-162), Blue Clay (162-170), Gray coarse sand (170-320), Gray coarse sand & shell (320-347), Blue Clay + clam shells (347-374), Gray med. sand (374-402), Blue Clay + clam shells (402-666), Gray coarse sand (666-675), Blue Clay (675-685), Gray coarse sand (685-756/886)

WELL LOCATION:

sec. 2 T. 8 S. R. 7 W. miles in of Gautier (distance) (direction) (nearest town)

WELL PURPOSE: Home (home, irrigation, municipal, industrial)

WELL COMPLETION DATA:

- (1) diameter (inches) 2 1/2"
(2) total depth (feet) 756'
(3) static water level (feet) 37' below top of ground
(4) casing PVC 736' (material) (depth)
(5) screen 2" (size) 20' (length) 736' (depth to top)
(6) pump 1 hp. (HP) 6 1/2 (yield gpm)
(7) electric log No (yes or no)
(organization running log)

(8) how well bottom plugged Backwash Valve


DRILLERS REMARKS:

RECEIVED NOV - 9 1978

MISS. BD. OF WATER COMMISSIONERS

If well telescopes please sketch and show depths.

GROUND LEVEL

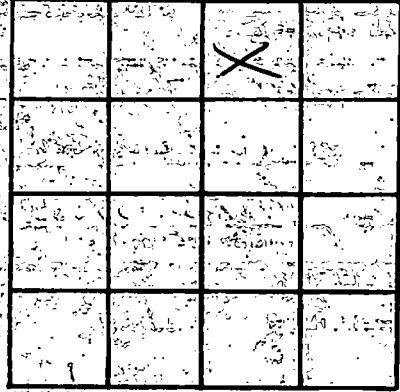

SECTION 2

Please indicate well location X.

ADDITIONAL INFORMATION

Multiple horizontal lines for additional information.

If more than one screen, show locations of each on sketch.