

**JACKSON**  
 Φ 2089  
 3-20-79

**MISSISSIPPI  
 BOARD OF WATER COMMISSIONERS**  
 416 North State Street  
 Jackson, Mississippi 39201

**WATER WELL DRILLERS LOG**

3-20-1979 date well completed      179 Coash Water Well Serv. Inc. firm name      Jackson county well located

**LANDOWNER:** Linda Harmon  
EF. Taylor  
Ph 3 - Ocean Springs,  
Miss. 39564  
 (mailing address)

**WELL LOCATION:**  
 sec. 38 T 7 R 7  
3 1/2 miles West of  Gautier  
 (distance) (direction) (nearest town)

**WELL PURPOSE:** None  
 (home, irrigation, municipal, industrial)

**WELL COMPLETION DATA:**

(1) diameter (inches) 2"

(2) total depth (feet) 302

(3) static water level (feet) 25' <sup>below</sup> <sub>above</sub> top of ground.

(4) casing PVC, 292'  
 (material) (depth)  
2"  
 (size) if telescope see back.

(5) screen 10', 292'  
 (length) (depth to top)  
2" PVC  
 (size) (material)

(6) pump 1/2 7-  
 (HP) (yield gpm)  
Elect.  
 (type power)

(7) electric log No  
 (yes or no)

(organization running log)

description of formations encountered	from	to
<u>Sandy Top soil</u>	<u>0</u>	<u>8</u>
<u>Blue Clay</u>	<u>8</u>	<u>53</u>
<u>Sand - Gravel</u>	<u>53</u>	<u>65</u>
<u>Blue Clay</u>	<u>65</u>	<u>110</u>
<u>Sand (M)</u>	<u>110</u>	<u>158</u>
<u>Blue Clay</u>	<u>158</u>	<u>269</u>
<u>Sand (M)</u>	<u>269</u>	<u>302</u>

(8) how well bottom plugged  
back wash valve

**DRILLERS REMARKS:**


Miss. Board of Water Comm.

MAY 29 1979

**RECEIVED**

If well telescopes please sketch and show depths.

GROUND LEVEL

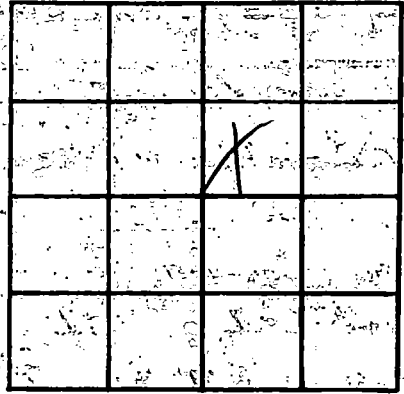

SECTION 38

Please indicate well location X.

ADDITIONAL INFORMATION

If more than one screen, show locations of each on sketch.