

JACKSON  
 O 2096  
 5-10-19

MISSISSIPPI  
 BOARD OF WATER COMMISSIONERS  
 416 North State Street  
 Jackson, Mississippi 39201

WATER WELL DRILLERS LOG

5-10-1979 date well completed  
 79 Coas White Water Supplies firm name  
 Jackson county well located

LANDOWNER: Don Laurel

Rt 7 - Box 272 - B.  
 Ocean Springs, Miss 39564  
 (mailing address)

WELL LOCATION:  
 sec. 19 T. 8 S. R. 7 E.  
 4 miles S. West of Gautier  
 (distance) (direction) (nearest town)

WELL PURPOSE: Home  
 (home, irrigation, municipal, industrial)

WELL COMPLETION DATA:

- (1) diameter (inches) 2"
- (2) total depth (feet) 504
- (3) static water level (feet) 22' (below above top of ground)
- (4) casing PVC 494'  
(material) (depth)  
2"  
(size) if telescope see back.
- (5) screen 10' 494  
(length) (depth to top)  
2" PVC  
(size) (material)
- (6) pump 1/2 h.p. 7  
(HP) (yield gpm)  
Elect.  
(type power)
- (7) electric log No  
(yes or no)  
(organization running log)

(8) how well bottom plugged backwash valve

DRILLERS REMARKS:

| description of formations encountered | from | to  |
|---------------------------------------|------|-----|
| Top soil                              | 0    | 1   |
| White Coarse sand                     | 1    | 80  |
| White Coarse sand + gravel            | 80   | 100 |
| Blue Clay                             | 100  | 191 |
| Gray med. sand                        | 191  | 197 |
| Blue Clay                             | 197  | 222 |
| Gray fine sand                        | 222  | 253 |
| Blue Clay + Shell for                 | 253  | 457 |
| Gray Coarse sand                      | 457  | 504 |


DEPT. OF NATURAL RESOURCES  
 BUREAU OF LAND & WATER RESOURCES

JAN 15 1980

RECEIVED

If well telescopes please sketch and show depths.

GROUND LEVEL

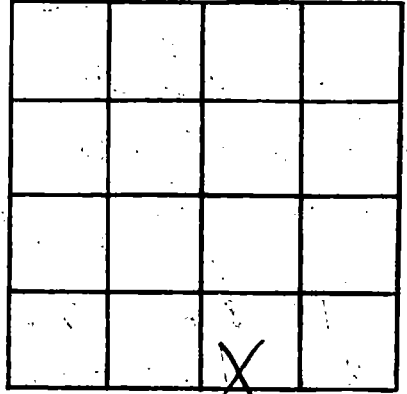

SECTION 19

Please indicate well location X.

ADDITIONAL INFORMATION

If more than one screen,  
show locations of each on sketch.