

Jackson  
# 2099  
6-15-79

MISSISSIPPI  
BOARD OF WATER COMMISSIONERS  
416 North State Street  
Jackson, Mississippi 39201

WATER WELL DRILLERS LOG

6-15-79 date well completed  
Coast Water Well Sew. Inc. firm name  
Jackson county well located

LANDOWNER: Lonnie Hopkins  
4812 Old Spanish Trail  
Gautier, Miss 39553  
(mailing address)

description of formations encountered	from	to
Top soil	0	4
Blue Clay	4	47
Gray Coarse sand	47	58
Blue Clay	58	100
Gray Coarse sand	100	145
Blue Clay	145	180
Gray Coarse sand	180	287
		161c

WELL LOCATION:  
sec 38 T 7 S R 7 W  
4 miles West of Gautier  
(distance) (direction) (nearest town)

WELL PURPOSE: Home  
(home, irrigation, municipal, industrial)

- WELL COMPLETION DATA:
- (1) diameter (inches) 2"
  - (2) total depth (feet) 287'
  - (3) static water level (feet) 18' below top of ground
  - (4) casing PVC, 277' (depth)  
2" (size) if telescope see back.
  - (5) screen 10' (length), 277' (depth to top)  
2" (size), PVC (material)
  - (6) pump 1 h.p. (HPV), 10 (yield gpm)  
Elec. (type power)
  - (7) electric log No. (yes or no)
- (organization running log)
- (8) how well bottom plugged  
Back with water

DEPT. OF NATURAL RESOURCES  
BUREAU OF LAND & WATER RESOURCES


JAN 25 1980

RECEIVED

DRILLERS REMARKS:

If well telescopes please sketch and show depths.

GROUND LEVEL

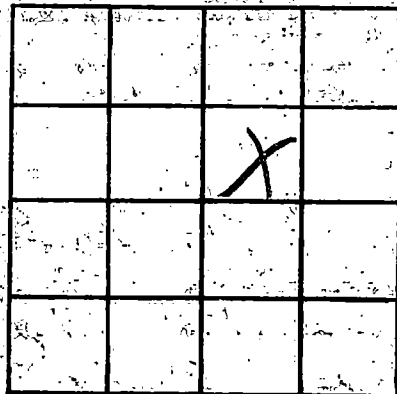

SECTION 38

Please indicate well location X.

ADDITIONAL INFORMATION

If more than one screen, show locations of each on sketch.