

JACKSON  
 # 2101  
 6-26-79

MISSISSIPPI  
 BOARD OF WATER COMMISSIONERS  
 416 North State Street  
 Jackson, Mississippi 39201

WATER WELL DRILLERS LOG

6-26-19 Coast Water Well Sew. Inc. Jackson  
 date well completed firm name county well located

LANDOWNER: Singing River Baptist Church  
P.O. Box 627  
Gautier, Miss  
 (mailing address)

WELL LOCATION:  
 sec. 35 T-7 S R-7 W  
 (distance) miles (direction) of Gautier  
 (nearest town)

WELL PURPOSE: Municipal  
 (home, irrigation, municipal, industrial)

WELL COMPLETION DATA:

(1) diameter (inches) 2"  
 (2) total depth (feet) 298'  
 (3) static water level (feet) 24' below above top of ground.  
 (4) casing PVC, 288'  
 (material) (depth)  
2" If telescope see back.  
 (size)  
 (5) screen 10', 288'  
 (length) (depth to top)  
2", PVC  
 (size) (material)  
 (6) pump 1 h.p., 7  
 (HP) (yield gpm)  
Electric  
 (type power)  
 (7) electric log No  
 (yes or no)  
 (organization running log)

description of formations encountered	from	to
	<u>Top soil</u>	<u>0</u>
<u>Gray Coarse sand</u>	<u>4</u>	<u>50</u>
<u>Blue Clay</u>	<u>50</u>	<u>190</u>
<u>Gray Coarse sand</u>	<u>190</u>	<u>298</u>
		<u>165 lb</u>

DEPT. OF NATURAL RESOURCES  
 BUREAU OF LAND & WATER RESOURCES

JAN 25 1980


RECEIVED

(8) how well bottom plugged:  
Back Wash Valve

DRILLERS REMARKS:

If well telescopes please sketch and show depths.

GROUND LEVEL

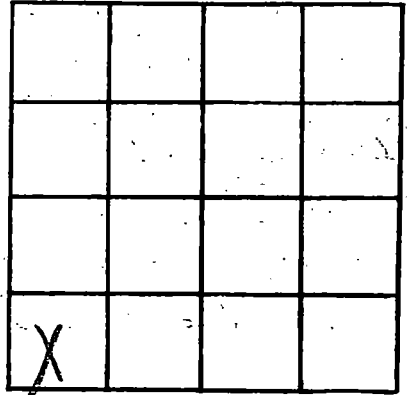

SECTION 35

Please indicate well location X.

ADDITIONAL INFORMATION

If more than one screen, show locations of each on sketch.