

JACKSON  
 2104  
 7-31-79

MISSISSIPPI  
 BOARD OF WATER COMMISSIONERS  
 416 North State Street  
 Jackson, Mississippi 39201

WATER WELL DRILLERS LOG

7-31-1979 date well completed  
 79 Coast Water Well Service, Jackson firm name  
 Jackson county well located

LANDOWNER: John Blank  
 701 Old Spanish Trail  
 Gautier, Miss. 39553  
 (mailing address)

description of formations encountered	from	to
Top soil	0	1
Red Clay	1	10
Gray Clay	10	25
Sand C.	25	60
		End Hole

WELL LOCATION:  
 sec. 4 T 8 R 7  
 miles in direction of Gautier  
 (distance) (direction) (nearest town)

WELL PURPOSE: Home  
 (home, irrigation, municipal, industrial)

- WELL COMPLETION DATA:
- diameter (inches) 2"
  - total depth (feet) 60'
  - static water level (feet) 15' below top of ground
  - casing PVC, 50' (depth)  
 2" (size) If telescope see back.
  - screen 10' (length), 50' (depth to top)  
 2" (size), PVC (material)
  - pump 1/2 h.p. (HP), 7 (yield gpm)  
 Elec (type power)
  - electric log No (yes or no)
- (organization running log)

(8) how well bottom plugged  
 Back wash valve

DRILLERS REMARKS:


DEPT. OF NATURAL RESOURCES  
 BUREAU OF LAND & WATER RESOURCES

FEB 26 1980

RECEIVED

If well telescopes please sketch and show depths.

GROUND LEVEL

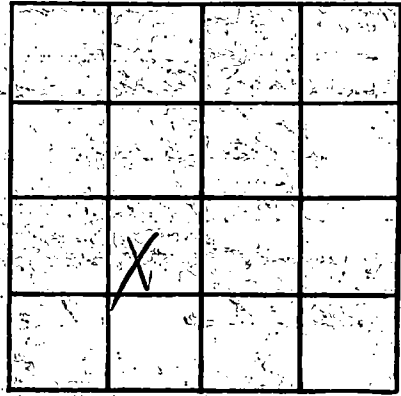

SECTION 4

Please indicate well location: X.

ADDITIONAL INFORMATION

If more than one screen, show locations of each on sketch.