

JACKSON
 Ø 2105
 8-20-79

MISSISSIPPI
 BOARD OF WATER COMMISSIONERS
 416 North State Street
 Jackson, Mississippi 39201

WATER WELL DRILLERS LOG

8-20-79 date well completed
 1979 Coast Artistic Well Serv. Inc. firm name
 Jackson county well located

LANDOWNER: William Shroder
Gautier, Miss.
 39553
 (mailing address)

WELL LOCATION:
 sec. 19 T 8 R 7
10 miles S. East of Osborne
 (distance) (direction) (nearest town)

WELL PURPOSE: None
 (home, irrigation, municipal, industrial)

WELL COMPLETION DATA:
 (1) diameter (inches) 3"
 (2) total depth (feet) 390'
 (3) static water level (feet) 25' ^{below} _{above} top of ground.
 (4) casing PVC 380'
 (material) (depth)
2" If telescope see back.
 (size)
 (5) screen 10' 380'
 (length) (depth to top)
2" PVC
 (size) (material)
 (6) pump 1/2 HP 6 1/2
 (type power) (yield gpm)
Electric
 (type power)
 (7) electric log No.
 (yes or no)
 (organization running log)

Description of formations encountered	from	to
Top soil sandy	0	17
Gray Clay	17	25
Sand (C)	25	78
Gray Clay	78	97
Sand (C)	97	129
Blue Clay	129	365
Sand (M)	365	390

(8) how well bottom plugged
fresh wash valve
 DRILLERS REMARKS:

DEPT. OF NATURAL RESOURCES
 BUREAU OF LAND & WATER RESOURCES


FEB 26 1980

RECEIVED

If well telescopes please sketch and show depths.

NO. 19
ET AL 10 24/37
NO. 37

GROUND LEVEL

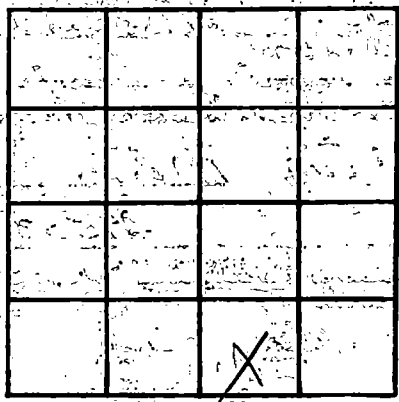

		X	

SECTION 19

Please indicate well location X.

ADDITIONAL INFORMATION

Blank ruled area for additional information.

If more than one screen, show locations of each on sketch.