

JACKSON
 2167
 8/26/79

MISSISSIPPI
 BOARD OF WATER COMMISSIONERS
 416 North State Street
 Jackson, Mississippi 39201
WATER WELL DRILLERS LOG

8-26-79 19 Switzer Well Co. JACKSON
 date well completed firm name county well located

LANDOWNER:	description of formations encountered	from	to
Lorenzo Fairley	Mixed Sand & Clay sand	0	22
Rt. 6, Box 143G	CLAY	22	43
OCEAN SPRINGS MS 39564	CLAY & SAND streaks	43	82
(mailing address)	CLAY	82	138
WELL LOCATION:	SANDY GRAVEL	138	182
sec. 8 T. 7 N. R. 7 E	CLAY & SAND streaks	182	202
6 miles NE of Ocean Springs MS	CLAY	202	208
(distance) (direction) (nearest town)	SAND	208	238
WELL PURPOSE: Home	CLAY	238	248
(home, irrigation, municipal, industrial)	SAND	248	261
WELL COMPLETION DATA:	CLAY	261	389
(1) diameter (inches) 2"	SAND fine	389	440
(2) total depth (feet) 594'	SAND 9000	440	460
(3) static water level (feet) 36' below top of ground.	SAND	460	507
(4) casing Steel 584' CL	CLAY	507	511
(material) (depth)	SAND	511	516
2" If telescope see back.	CLAY & shale	516	559
(size)	SAND & small gravel	559	594
(5) screen 10' 584'			
(length) (depth to top)			
2" STAINLESS STEEL			
(size) (material)			
(6) pump 1 12			
(HP) (yield gpm)			
AC			
(type power)			
(7) electric log NO			
(yes or no)			
(organization running log)			
(8) how well bottom plugged METAL			
BACKWASH			
DRILLERS REMARKS:			


Miss. Board of Water Comm.

AUG 28 1979

RECEIVED

If well telescopes please sketch and show depths.

GROUND LEVEL

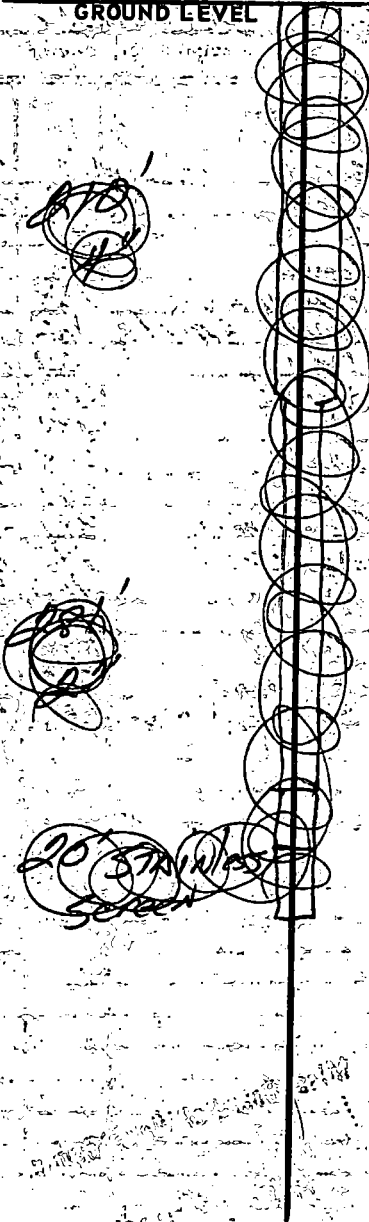

X			

SECTION 8

Please indicate well location X.

ADDITIONAL INFORMATION

If more than one screen, show locations of each on sketch.