

MISSISSIPPI DEPARTMENT OF NATURAL RESOURCES

Bureau of Land and Water Resources

Southport Mall

P.O. Box 10631

Jackson, Mississippi 39209

WATER WELL DRILLERS LOG

COASTAL DRILLING & SERVICE CO.

JACKSON
 212
 11-28-79

11/28/79
 date well completed

ROUTE 618

Jackson
 county well located

LANDOWNER: David Miller, BIRDA, MISS. 39552

description of formations encountered	from	to
Top Soil	1	3
Cal Red Clay	3	25
Swamp Sand	25	115
Clay & white sand	115	140
Soft Blue Clay	140	250
hard Blue Clay	250	370
fine watered + clay	370	380
Coarse white sand	380	418

Pt 4
 Ocean Spring Min
 (mailing address)

WELL LOCATION:

sec. 5 T. 25 R. 25
 1/2 mile North of Famball
 (distance) (direction) (nearest town)

WELL PURPOSE: home
 (home, irrigation, municipal, industrial)

WELL COMPLETION DATA:

- (1) diameter (inches) 4 1/2"
- (2) total depth (feet) 418'
- (3) static water level (feet) 35' below top of ground
- (4) casing PVC 403' (material) (depth)
 4 1/2" (size) If telescope see back.
- (5) screen 15' 403' (length) (depth to top)
 2" (size) PVC (material)
- (6) pump One 70 (HP) (y/old gpm)
 Ele (type power)
- (7) electric log NO (yes or no)

(organization running log)

(8) how well bottom plugged
 2' back wash valve

DRILLERS REMARKS: 19-B


DEPT. OF NATURAL RESOURCES
 BUREAU OF LAND & WATER RESOURCES

NOV - 5 1980

RECEIVED

If well telescopes please sketch and show depths.

GROUND LEVEL

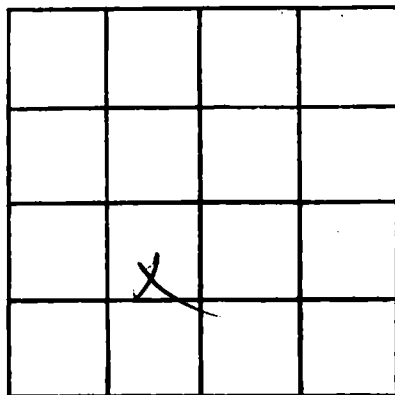

SECTION _____

Please indicate well location X.

ADDITIONAL INFORMATION

If more than one screen, show locations of each on sketch.