

JACKSON
02115
12-27-79

MISSISSIPPI
 BOARD OF WATER COMMISSIONERS
 416 North State Street
 Jackson, Mississippi 39201

WATER WELL DRILLERS LOG

Dec 27 1979 date well completed
Duncan Well Drilling Jackson firm name
Jackson county well located

LANDOWNER: Mr. Belden
1405 Bay Ridge Dr.
Hautier, Mo
 (mailing address)

description of formations encountered	from	to
<u>top sand</u>	<u>0</u>	<u>60</u>
<u>clay</u>	<u>60</u>	<u>212</u>
<u>fine sand</u>	<u>212</u>	<u>300</u>
<u>course sand</u>	<u>300</u>	<u>348</u>

WELL LOCATION:
 sec. 14 T. 8 N. R. 7 E.
In Hautier
 (distance) (direction) (nearest town)

WELL PURPOSE: Home
 (home, irrigation, municipal, industrial)

- WELL COMPLETION DATA:
- (1) diameter (inches) 2"
 - (2) total depth (feet) 348 ft.
 - (3) static water level (feet) 38' below above top of ground.
 - (4) casing PVC, 338'
 (material) (depth)
 - (size) If telescope see back.
 - (5) screen 10', 338'
 (length) (depth to top)
 - 2", PVC
 (size) (material)
 - (6) pump 1, 12
 (HP) (yield gpm)
 - electric
 (type power)
 - (7) electric log —
 (yes or no)
 - (organization running log)
 - (8) how well bottom plugged Sand
shark

DRILLERS REMARKS:


DEPT. OF NATURAL RESOURCES
 BUREAU OF LAND & WATER RESOURCES

JAN 15 1980

RECEIVED

If well telescopes please sketch and show depths.

GROUND LEVEL

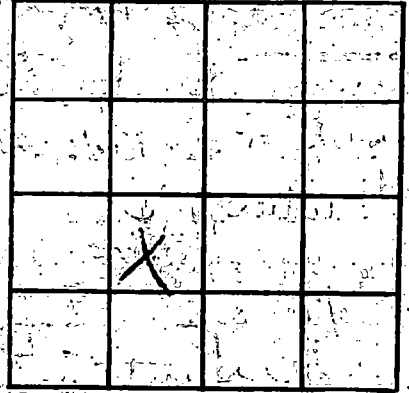

SECTION 14

Please indicate well location X.

ADDITIONAL INFORMATION

If more than one screen, show locations of each on sketch.