

Jackson  
 2/21  
 5-13-80

MISSISSIPPI  
 BOARD OF WATER COMMISSIONERS  
 416 North State Street  
 Jackson, Mississippi 39201

WATER WELL DRILLERS LOG

4-3 19 Bradley Pump & Well Service, Inc JACKSON  
 date well completed firm name county well located

LANDOWNER:	description of formations encountered	from	to
CHARLES Mouchette 208 Oak St Gautier, MS (mailing address)	Clay	0	80
	Sand	80	130
	Clay	130	210
	Sand	210	230
	Clay	230	270
	Sand	270	340
	Clay	340	438
	Sand	438	460
			186e
WELL LOCATION: sec. <u>8</u> T. <u>7</u> S. R. <u>7</u> W. (distance) miles <u>1/4</u> (direction) of <u>Gautier</u> (nearest town)			
WELL PURPOSE: (home, irrigation, municipal, industrial)			
WELL COMPLETION DATA:			
(1) diameter (inches) <u>2"</u>			
(2) total depth (feet) <u>460'</u>	well 2,50		
(3) static water level (feet) <u>50</u> (below/above top of ground)			
(4) casing <u>PVC</u> (material), <u>total</u> (depth) <u>2"</u> (size) If telescope see back.			
(5) screen <u>10'</u> (length), <u>440'</u> (depth to top) <u>2"</u> (size), <u>100% PVC underbar</u> (material)			
(6) pump <u>1</u> (HP), <u>10</u> (yield gpm) <u>230</u> (type power)			
(7) electric log <u>NO</u> (yes or no) (organization running log)			
(8) how well bottom plugged <u>2" sand shark</u>			
DRILLERS REMARKS: <u>10' tail pipe</u>			


DEPT. OF NATURAL RESOURCES  
 BUREAU OF LAND & WATER RESOURCES

MAY 7 - 1980

RECEIVED

If well telescopes please sketch and show depths.

GROUND LEVEL

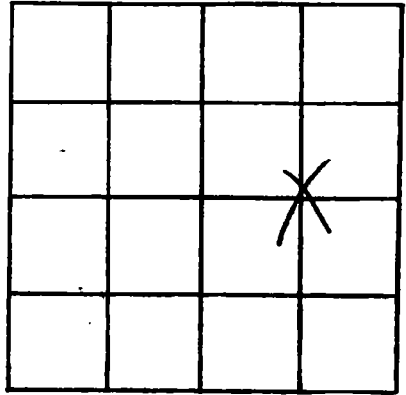

SECTION 8

Please indicate well location X.

ADDITIONAL INFORMATION

If more than one screen,  
show locations of each on sketch.