

MISSISSIPPI DEPARTMENT OF NATURAL RESOURCES
Bureau of Land and Water Resources
 Southport Mall
 P.O. Box 10631
 Jackson, Mississippi 39209
WATER WELL DRILLERS LOG

Jackson
0224

8-10-83 19 Coast Water Well Serv. Jackson
 date well completed firm name county well located

LANDOWNER: Shirley Derbyshire
Joe Fountain Rd.
Ocean Springs, Miss.
 (mailing address) 39564

WELL LOCATION:
 sec. 1 T. 8 N. R. 2 E.
4 miles SE of Ocean Springs
 (distance) (direction) (nearest town)

WELL PURPOSE: Home
 (home, irrigation, municipal, industrial)

- WELL COMPLETION DATA:
- (1) diameter (inches) 2"
 - (2) total depth (feet) 488'
 - (3) static water level (feet) 69' below above
 top of ground.
 - (4) casing PVC 478'
 (material) (depth)
2" If telescope see back.
 (size)
 - (5) screen 10' 478'
 (length) (depth to top)
2" PVC
 (size) (material)
 - (6) pump 1hp 7
 (HP) (yield gpm)
Electric
 (type power)
 - (7) electric log No.
 (yes or no)
 (organization running log)
 - (8) How well bottom plugged?
Backwash valve


description of formations encountered	from	to
Top soil	0	2'
Red coarse sand	2'	43'
Blue Clay & streak of sand	43'	65'
Blue Clay	65'	180'
Gray Med. Sand	180'	200'
Blue Clay	200'	275'
Blue Clay & streak of sand	275'	383'
Blue Clay	383'	445'
Gray coarse sand	445'	478'
Blue Clay	478'	488'

DEPT. OF NATURAL RESOURCES
 BUREAU OF LAND & WATER RESOURCES
 SEP 21 1983
RECEIVED

DRILLERS REMARKS:

**if well telescopes please
sketch and show depths.**

GROUND LEVEL

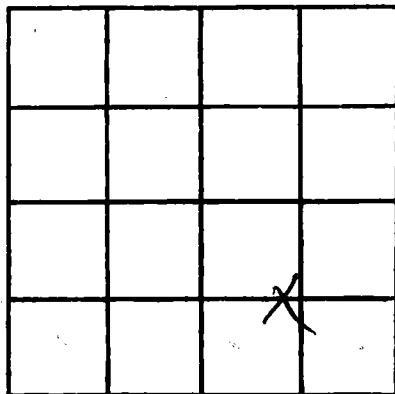

SECTION

Please indicate well location X.

ADDITIONAL INFORMATION

**If more than one screen,
show locations of each on sketch.**