

MISSISSIPPI DEPARTMENT OF NATURAL RESOURCES

Bureau of Land and Water Resources

Southport Mall

P.O. Box 10631

Jackson, Mississippi 39209

WATER WELL DRILLERS LOG

JACKSON  
 2125  
 8-5-80

8-5-1980 date well completed  
 80 Duncan Well Drilling firm name  
 Jackson county well located

LANDOWNER:	description of formations encountered	from	to
Rev. Charles McKenney Jesus Christ Baptist Temple Ocean Springs, Ms. (mailing address)	clay coarse sand	0 55	55 80
<b>WELL LOCATION:</b>			
sec. <u>20</u> T. <u>7</u> N. R. <u>1</u> E. 9 miles <u>N.W.</u> of <u>Laurel</u> (distance) (direction) (nearest town)			
<b>WELL PURPOSE:</b> <u>municipal</u> (home, irrigation, municipal, industrial)			
<b>WELL COMPLETION DATA:</b>			
(1) diameter (inches) <u>2"</u>			
(2) total depth (feet) <u>80 ft.</u>			
(3) static water level (feet) <u>6"</u> <input checked="" type="checkbox"/> below <input type="checkbox"/> above top of ground.			
(4) casing <u>PVC</u> <u>80'</u> (material) (depth)			
<u>        </u> (size) if telescope see back.			
(5) screen <u>10'</u> <u>80'</u> (length) (depth to top)			
<u>2"</u> <u>PVC</u> (size) (material)			
(6) pump _____ (HP) _____ (yield gpm) (type power)			
(7) electric log _____ (yes or no)			
<u>        </u> (organization running log)			
(8) how well bottom plugged <u>Sand</u> <u>Shark</u>			
DRILLERS REMARKS: <u>Res. McKenney installed his own pump</u>			


DEPT. OF NATURAL RESOURCES  
 BUREAU OF LAND & WATER RESOURCES

OCT 31 1980

RECEIVED

If well telescopes please sketch and show depths.

GROUND LEVEL

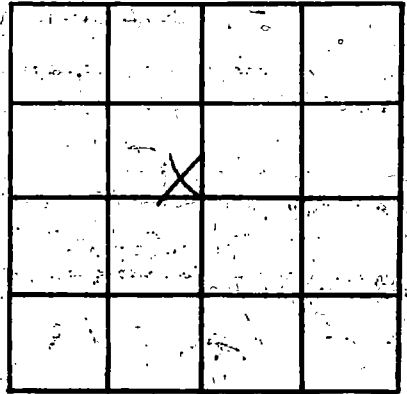

SECTION 20

Please indicate well location X.

ADDITIONAL INFORMATION

If more than one screen, show locations of each on sketch.