

JACKSON
 2131
 11-7-80
 11-7-

MISSISSIPPI
 BOARD OF WATER COMMISSIONERS
 416 North State Street
 Jackson, Mississippi 39201

WATER WELL DRILLERS LOG

date well completed

firm name

county well located

80 Coast Water Well Sew. Jackson

LANDOWNER

description of formations encountered

from

to

W. H. Murphy
 3800 Seamanist
 Gautier, Miss.
 (mailing address) 39533

description of formations encountered	from	to
Top soil	0	3'
Gray clay	3	15'
O sand	15	25'
Blue clay	25	100'
M. sand	100	140'
Blue clay	140	220'
C. sand	220	225'

WELL LOCATION:

sec. 36 T 7 N R 7 E
 10 miles (distance) of GAUTIER (direction) (nearest town)

WELL PURPOSE: Home
 (home, irrigation, municipal, industrial)

WELL COMPLETION DATA:

- (1) diameter (inches) 2"
- (2) total depth (feet) 225'
- (3) static water level (feet) 15' below top of ground
- (4) casing PVC, 225' (material) (depth)
 2" (size) If telescope see back.
- (5) screen 10' length, 225' depth to top
 2" (size) PVC (material)
- (6) pump 1 h.p. 12 (HP) (yield gpm)
 Elec (type power)
- (7) electric log No. (yes or no)
 N/A (organization running log)

(8) has well bottom plugged
 Back Wash Valve

DRILLERS REMARKS:


DEPT. OF NATURAL RESOURCES
 BUREAU OF LAND & WATER RESOURCES

APR 6 1981

RECEIVED

If well telescopes please sketch and show depths.

GROUND LEVEL

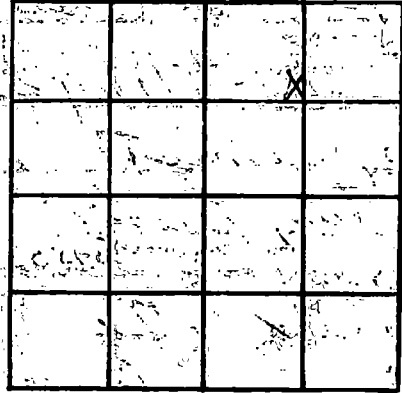

SECTION 36

Please indicate well location X.

ADDITIONAL INFORMATION

Multiple horizontal lines for writing additional information.

If more than one screen, show locations of each on sketch.