

MISSISSIPPI DEPARTMENT OF NATURAL RESOURCES

Bureau of Land and Water Resources

Southport Mall

P.O. Box 10631

Jackson, Mississippi 39209

WATER WELL DRILLERS LOG

Jackson
 2132
 1-6-81

1-6-81 date well completed

81 Coast Water Well Sewer firm name

Jackson county well located

LANDOWNER: P.M. "Bo" Sped
 P.O. Box 2132
 Martin Bluff Rd.
 Gautier, Miss. 39153
 (mailing address)

description of formations encountered

from to

Top soil	0'	2'
Gray Clay	2'	59'
C. Sand	59'	70'

WELL LOCATION:

sec. 27 T 7 N R 7
 1N miles of GAUTIER
 (distance) (direction) (nearest town)

WELL PURPOSE: Home
 (home, irrigation, municipal, industrial)

WELL COMPLETION DATA:

- (1) diameter (inches) 2"
- (2) total depth (feet) 70'
- (3) static water level (feet) 20' below top of ground
- (4) casing PVC 60' (material) (depth)
 2" (size) if telescope see back.
- (5) screen 10' 60' (length) (depth to top)
 2" (size) PVC (material)
- (6) pump 1 h.p. 8 (HP) (yield gpm)
 Elect. (type power)
- (7) electric log No. (yes or no)
 No. (organization running log)

(8) how well bottom plugged Back Wash Valve

DRILLERS REMARKS:


DEPT. OF NATURAL RESOURCES
 BUREAU OF LAND & WATER RESOURCES

APR - 6 1981

RECEIVED

If well telescopes please sketch and show depths.

GROUND LEVEL

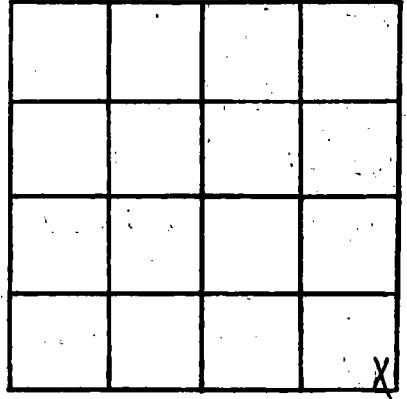

SECTION 27

Please indicate well location X.

ADDITIONAL INFORMATION

If more than one screen, show locations of each on sketch.