

MISSISSIPPI DEPARTMENT OF NATURAL RESOURCES

Bureau of Land and Water Resources

Southport Mall

P.O. Box 10631

Jackson, Mississippi 39209

WATER WELL DRILLERS LOG

12

JACKSON  
Ø 2134  
3-31-81

3-31-19  
date well completed

Coast Water Well Serv.  
firm name

Jackson  
county well located

LANDOWNER: Shepard Park  
Gautier,  
Miss. 39533  
(mailing address)

description of formations encountered	from	to
<u>Sand Top Soil</u>	<u>0</u>	<u>5'</u>
<u>B. Clay</u>	<u>5'</u>	<u>40'</u>
<u>M. sand - B Clay</u>	<u>40'</u>	<u>50'</u>
<u>Ø sand</u>	<u>50'</u>	<u>75'</u>

WELL LOCATION:  
sec. E64T 8 S R. 2 E  
1N miles of CAWSTIER  
(distance) (direction) (nearest town)

WELL PURPOSE: None  
(home, irrigation, municipal, industrial)

WELL COMPLETION DATA:

- (1) diameter (inches) 2"
- (2) total depth (feet) 75'
- (3) static water level (feet) 18' below top of ground.
- (4) casing PVC 65'  
(material) (depth)  
2" if telescope see back.  
(size)
- (5) screen 10' 65'  
(length) (depth to top)  
2" PVC  
(size) (material)
- (6) pump \_\_\_\_\_ (HP) \_\_\_\_\_ (yield gpm)  
(type power)
- (7) electric log No.  
(yes or no)  
(organization running log)

(8) how well bottom plugged  
Back Wash Valve

DRILLERS REMARKS:


DEPT. OF NATURAL RESOURCES  
BUREAU OF LAND & WATER RESOURCES

JUN 2 - 1981

RECEIVED

If well telescopes please sketch and show depths.

GROUND LEVEL

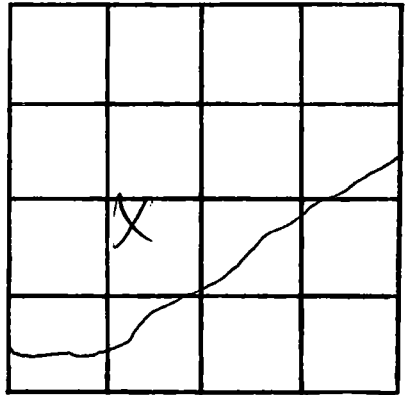

SECTION FG4

Please indicate well location X.

ADDITIONAL INFORMATION

If more than one screen,  
show locations of each on sketch.