

MISSISSIPPI DEPARTMENT OF NATURAL RESOURCES

Bureau of Land and Water Resources

Southport Mall

P.O. Box 10631

Jackson, Mississippi 39209

WATER WELL DRILLERS LOG

Jackson
 Q 2136
 4-27-81

4-27-81 date well completed
 81-Corb Water Well Sewer Jackson firm name county/well located

LANDOWNER

Therese M. Davis

description of formations encountered

from

to

P.O. Box 5426
 Moss Point, Miss.
 (mailing address) 39563

Top soil	0	3'
A. Clay	3'	15'
B. Clay	15'	45'
C. sand	45'	70'
B. Clay	70'	90'
C. sand	90'	120'
B. Clay	120'	165'
C. sand	165'	185'
B. Clay	185'	195'
M. sand	195'	225'

WELL LOCATION:

sec 36 T 7 N R 7 E
 1N miles (distance) of GAULT (direction) of (nearest town)

WELL PURPOSE:

(home, irrigation, municipal, industrial) *Home*

WELL COMPLETION DATA:

- (1) diameter (inches) 2"
- (2) total depth (feet) 225'
- (3) static water level (feet) 15' (below top of ground)
- (4) casing PVC (material), 225' (depth)
- 2" (size) if telescope see back.
- (5) screen 10' (length), 225' (depth to top)
- 2" (size), PVC (material)
- (6) pump — (HP), — (yield gpm)
- (type power)
- (7) electric log No. (yes or no)
- (organization running log)


(8) how well bottom plugged
backwash valve

DRILLERS REMARKS:

DEPT. OF NATURAL RESOURCES
 BUREAU OF LAND & WATER RESOURCES
 JUN 2 - 1981
 RECEIVED

If well telescopes please sketch and show depths.

GROUND LEVEL

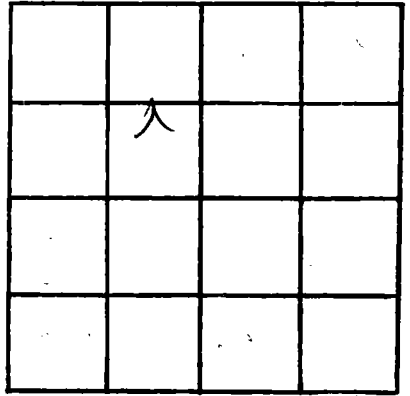

SECTION 36

Please indicate well location X.

ADDITIONAL INFORMATION

If more than one screen,
show locations of each on sketch.