

MISSISSIPPI DEPARTMENT OF NATURAL RESOURCES

Bureau of Land and Water Resources

Southport Mall

P.O. Box 10631

Jackson, Mississippi 39209

WATER WELL DRILLERS LOG

JACKSON
 2187
 4-29-81
 4-29-81

date well completed

firm name

county well located

Coast Water Well Serv. Co. Jackson

LANDOWNER:

Van W. Juey

description of formations encountered

from

to

7412 Ocean Springs Rd.
 Ocean Springs, Miss.
 (mailing address) 39564

Top soil 0 10'
 10- log -

WELL LOCATION:

sec. 18 T. 7 N. R. 7 E.
 3 miles NE of Ocean Springs
 (distance) (direction) (nearest town)

blue clay 10 60
 white coarse sand 60 87'
 blue clay and blue sand 87 110'

WELL PURPOSE:

(home, irrigation, municipal, industrial)

Home

blue clay 110 195'

WELL COMPLETION DATA:

- (1) diameter (inches) 2"
- (2) total depth (feet) 531'
- (3) static water level (feet) 28' below top of ground
- (4) casing PVC 521' (material) (depth)
- (5) screen 2" (size) 10' (length) PVC 521' (material) (depth to top)
- (6) pump 1 1/2" (HP) 12 (yield gpm)
- (7) electric log (type power) No. (yes or no)

blue clay and blue sand 195 248'
 gray coarse sand and wood 248 268'
 blue clay 268 444'
 gray fine sand 444 492'
 gray coarse sand 492 531'
 Hole

(organization running log)

(8) how well bottom plugged
 back wash valve

DRILLERS REMARKS:


DEPT. OF NATURAL RESOURCES
 BUREAU OF LAND & WATER RESOURCES

JUN 2 - 1981

RECEIVED

If well telescopes please sketch and show depths.

GROUND LEVEL

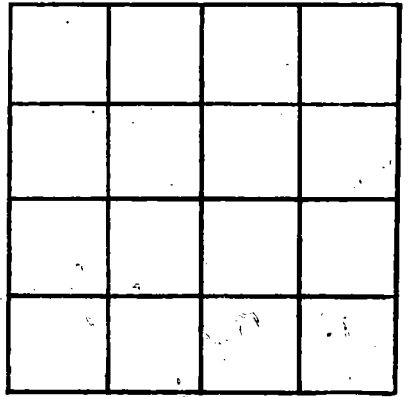

SECTION _____

Please indicate well location X.

ADDITIONAL INFORMATION

If more than one screen,
show locations of each on sketch.