

MISSISSIPPI DEPARTMENT OF NATURAL RESOURCES

Bureau of Land and Water Resources

Southport Mall

P.O. Box 10631

Jackson, Mississippi 39209

WATER WELL DRILLERS LOG

JACKSON
 2138
 4-30-81

4-30-81 date well completed
 81 Coast Water Well Sew. firm name
 Jackson county well located

LANDOWNER: Robert Demore
 P.O. Box 569
 Ocean Springs, Miss.
 (mailing address) 32644

description of formations encountered	from	to
Top soil	0	3'
B. clay	3'	35'
M. sand	35'	75'
		Hole

WELL LOCATION:
 sec. 17 T. 7 S. R. 7 W.
 5 miles ENE of OCEAN SPRINGS
 (distance) (direction) (nearest town)

WELL PURPOSE: Home
 (home, irrigation, municipal, industrial)

WELL COMPLETION DATA:

(1) diameter (inches) 2"

(2) total depth (feet) 75'

(3) static water level (feet) 50' below top of ground.

(4) casing PVC, 65' (material) (depth)
 2" (size) If telescope see back.

(5) screen 10' (length), 65' (depth to top)
 3" (size), PVC (material)

(6) pump (HP) (yield gpm)
 (type power)

(7) electric log No. (yes or no)
 (organization running log)

(8) How well bottom plugged
 Back Wash Valve

DEPT. OF NATURAL RESOURCES
 BUREAU OF LAND & WATER RESOURCES


JUN 2 - 1981

RECEIVED

DRILLERS REMARKS:

If well telescopes please sketch and show depths.

GROUND LEVEL

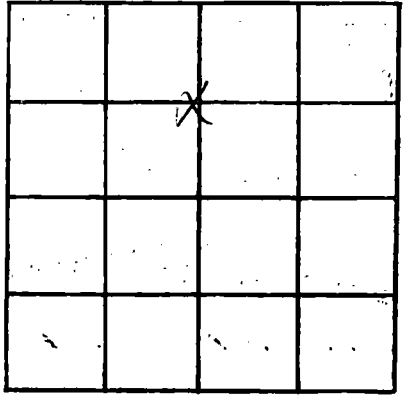

SECTION 17

Please indicate well location X.

ADDITIONAL INFORMATION

If more than one screen, show locations of each on sketch.