

MISSISSIPPI DEPARTMENT OF NATURAL RESOURCES

Bureau of Land and Water Resources

Southport Mall

P.O. Box 10631

Jackson, Mississippi 39209

WATER WELL DRILLERS LOG

JACKSON  
0 2139  
5-29-81

5-29-81  
date well completed

Bas Water Well Sew. Inc. Jackson  
firm name county well located

LANDOWNER: United Methodist Church  
P.O. Box 127  
Gautier, Miss. 39553  
(mailing address)

description of formations encountered	from	to
Top soil	0	3'
Blue Clay	3'	64'
Blue Clay & Wood	64'	73'
White Coarse sand	73'	80'
blue Clay	80'	175'
gray med. sand	175'	188'
Blue Clay	188'	200'
gray Coarse sand	200'	299'

WELL LOCATION:  
sec. 35 T-7 R-7  
W miles (distance) of GAUTIER (direction) (nearest town)

WELL PURPOSE: Home  
(home, irrigation, municipal, industrial)

WELL COMPLETION DATA:  
(1) diameter (inches) 2"  
(2) total depth (feet) 299'  
(3) static water level (feet) 30' below above top of ground.  
(4) casing PVC, 289' (material) (depth)  
2" (size) If telescope see back.  
(5) screen 10' (length), 289' (depth to top)  
2" (size) PVC (material)  
(6) pump 1 hp. (HP), 10- (yield gpm)  
Elect. (type power)  
(7) electric log No. (yes or no)  
 (organization running log)


(8) How well bottom plugged?  
back wash valve

DRILLERS REMARKS:



If well telescopes please sketch and show depths.

GROUND LEVEL

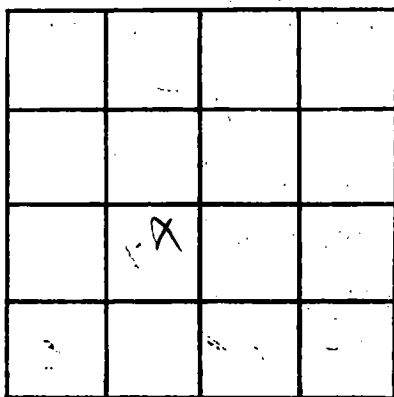

SECTION 35

Please indicate well location X.

ADDITIONAL INFORMATION

If more than one screen,  
show locations of each on sketch.