

MISSISSIPPI DEPARTMENT OF NATURAL RESOURCES

Bureau of Land and Water Resources

Southport Mall

P.O. Box 10631

Jackson, Mississippi 39209

WATER WELL DRILLERS LOG

Jackson
Q 2150
6-18-81

6-18-81 date well completed
Castleton Well Service firm name
Jackson county well located

LANDOWNER	description of formations encountered	from	to
Las Vegas, Miss 39567 (mailing address)	Top Soil - sand	0	20'
	Blue Clay	20'	80'
	C. sand	80'	125'
	Blue Clay	125'	153'
	M Sand	153'	180'
	B. Clay	180'	210'
	M.C. Sand	210'	340'
	B. Clay	340'	350'
	B. Clay	350'	505'
	C. sand	505'	580'

WELL LOCATION:

sec 8 T 8 N R 2 E
IN miles (distance) of GAULTIER (direction) (nearest town)

WELL PURPOSE: home (home, irrigation, municipal, industrial)


WELL COMPLETION DATA:

- (1) diameter (inches) 2"
- (2) total depth (feet) 580'
- (3) static water level (feet) 40' below top of ground
- (4) casing PVC 570' (material) (depth)
- (5) screen 2" (size) if telescope see back. 10' (length) 570' (depth to top)
- (6) pump 1 hp (HP) 7 1/2 (yield gpm) PUC (material)
- (7) electric log (type power) Elect. (yes or no)

(organization running log)


(8) how well bottom plugged
backwash valve

DRILLERS REMARKS:

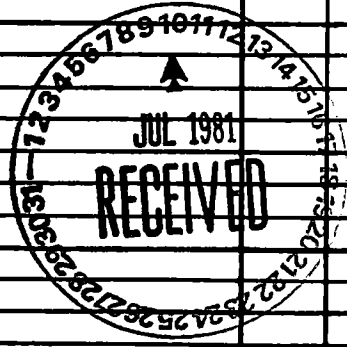

If well telescopes please sketch and show depths.

GROUND LEVEL

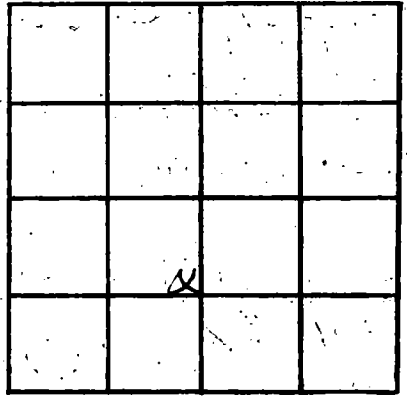

SECTION FG14

Please indicate well location X.

ADDITIONAL INFORMATION

If more than one screen, show locations of each on sketch.