

MISSISSIPPI DEPARTMENT OF NATURAL RESOURCES

Bureau of Land and Water Resources

Southport Mall

P.O. Box 10631

Jackson, Mississippi 39209

WATER WELL DRILLERS LOG

Jackson
Q 2141
6-25-81

6-25-81 date well completed 81 Cross & Water Well Sew. firm name Jackson county well located

LANDOWNER:

Richard Martin
1305 Hickory Hill Dr
Gautier, Miss.
(mailing address)

description of formations encountered

from to

Top soil	0	20'
B. Clay	20'	22.5'
M. sand	22.5'	24.5'
S. Clay	24.5'	37.5'
C. Sand	37.5'	42.0'

WELL LOCATION:

sec. 17 T-8 S R-7 W
0.1/2 miles SW of Ocean Springs
(distance) (direction) (nearest town)

WELL PURPOSE:


Home (home, irrigation, municipal, industrial)

WELL COMPLETION DATA:

- (1) diameter (inches) 2"
- (2) total depth (feet) 42.0'
- (3) static water level (feet) 20' below top of ground
- (4) casing PVC 410' (material) (depth)
- (5) screen 2" 10' 410' (size) (length) (depth to top)
- (6) pump 1 hp 10 (HP) (yield gpm)
Elect. (type power)
- (7) electric log No. (yes or no)
- (organization running log)

(8) How well bottom plugged
Back wash valve

DRILLERS REMARKS:

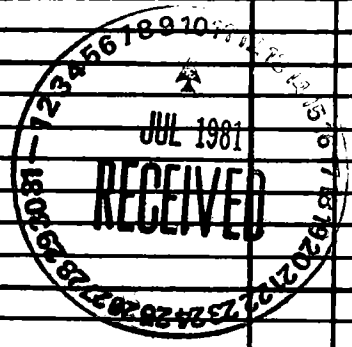

If well telescopes please sketch and show depths.

GROUND LEVEL

	X		

SECTION 17

Please indicate well location X.

ADDITIONAL INFORMATION

If more than one screen, show locations of each on sketch.

