

MISSISSIPPI DEPARTMENT OF NATURAL RESOURCES

Bureau of Land and Water Resources

Southport Mall

P.O. Box 10631

Jackson, Mississippi 39209

WATER WELL DRILLERS LOG

JACKSON
 2144
 7-7-81

7-7-81 date well completed
 81 Coast & Water Well Service, Inc. firm name
 Jackson county well located

LANDOWNER: Blaise W. Corner
1521 Bayou Vista
Gautier, Miss.
 (mailing address) 39553

description of formations encountered	from	to
Top soil	0	3'
S. Clay	3'	50'
A. Sand	50'	180'
B. Clay	180'	195'
C. Sand	195'	270'

WELL LOCATION:
 sec 36 T 1 R 7
IN miles (distance) of GAUTIER (nearest town)

WELL PURPOSE: Home
 (home, irrigation, municipal, industrial)

WELL COMPLETION DATA:

(1) diameter (inches) 2"

(2) total depth (feet) 270'

(3) static water level (feet) 10 ^{below}/_{above} top of ground.

(4) casing PVC, 260' (material) (depth)
2" (size) If telescope see back.

(5) screen 10', 260' (length) (depth to top)
5" (size), PVC (material)

(6) pump 1 hp, 10 (HP) (yield gpm)
Elec (type power)

(7) electric log No (yes or no)
 (organization running log)

(8) how well bottom plugged:
Backwash Valve

DRILLERS REMARKS:


DEPT. OF NATURAL RESOURCES
 BUREAU OF LAND & WATER RESOURCES

AUG 14 1981

RECEIVED

If well telescopes please sketch and show depths.

GROUND LEVEL

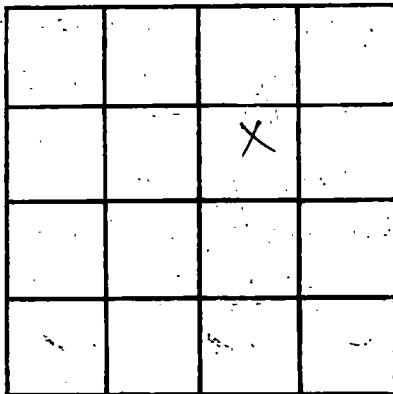

SECTION 36

Please indicate well location X.

ADDITIONAL INFORMATION

If more than one screen, show locations of each on sketch.