

JACKSON  
Q 2145

MISSISSIPPI  
BOARD OF WATER COMMISSIONERS  
416 North State Street  
Jackson, Mississippi 39201

WATER WELL DRILLERS LOG

7/30/78

7/30

date well completed

1978 Coastal Drilling

Drill name

Jackson

county well located

LANDOWNER: Bob Moran

RTS

Ocean Springs Min  
(mailing address)

WELL LOCATION:

sec. 8 T 7 N R 7 E

2 1/2 miles North of Ocean Springs  
(distance) (direction) (nearest town)

WELL PURPOSE:

home  
(home, irrigation, municipal, industrial)

WELL COMPLETION DATA:

- (1) diameter (inches) 2"
- (2) total depth (feet) 430'
- (3) static water level (feet) 40' below above top of ground.
- (4) casing PVC 420' (material) (depth)

(size) If telescope see back.

- (5) screen 10' 420' (length) (depth to top)
- 2" PVC (size) (material)

- (6) pump one 12 (HP) (yield gpm)
- 4hp (type power)

- (7) electric log no (yes or no)

(organization running log)

- (8) how well bottom plugged

2" leaded wire

DRILLERS REMARKS:

description of formations encountered

from

to

Top Soil	1	3
Red Clay	3	18
Sandy Soil	18	40
Soft Blue Clay	40	65
Sandy Soil	65	140
Soft Blue Clay	140	210
Yellow Clay	210	230
Soft Blue Clay	230	300
Hard Blue Clay	300	380
Fine Water Silt	380	400
Good Water Sand	400	430


Miss. Board of Water Comm.

APR 6 - 1979

RECEIVED

If well telescopes please  
sketch and show depths.

GROUND LEVEL

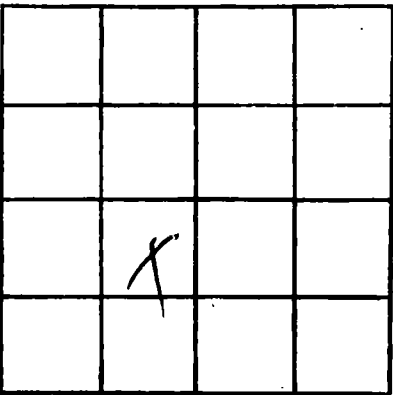

SECTION \_\_\_\_\_

Please indicate well location X.

ADDITIONAL INFORMATION

If more than one screen,  
show locations of each on sketch.