

MISSISSIPPI DEPARTMENT OF NATURAL RESOURCES

Bureau of Land and Water Resources

Southport Mall

P.O. Box 10631

Jackson, Mississippi 39209

WATER WELL DRILLERS LOG

JACKSON
 2146
 7-10-81

7-10 date well completed 81 Coast Water Well Service firm name Jackson county well located

LANDOWNER: Bertha Rose

description of formations encountered

from to

Gautier, Miss
 39553
 (mailing address)

Top soil 0 6'

Red Clay 6 18'

Blue Clay 18' 50'

Gray Coarse sand & wood 50' 86'

WELL LOCATION:

sec. 36 T 7 N R 7 E
1N miles of GAUTIER
 (distance) (direction) (nearest town)

WELL PURPOSE: home
 (home, irrigation, municipal, industrial)

Gray Coarse sand and gravel 86' 126'

WELL COMPLETION DATA:

Blue Clay + streak of sand 126' 130'

(1) diameter (inches) 2"
 (2) total depth (feet) 287

Gray Coarse sand and gravel 130' 175'

(3) static water level (feet) 20' below top of ground.

Blue Clay 175' 195'

(4) casing PVC 277'
 (material) (depth)

Gray fine sand 195' 269'

2" If telescope see back.
 (size)

Gray Coarse sand 269' 287'

(5) screen 10' 277'
 (length) (depth to top)

2" PVC
 (size) (material)

(6) pump 1/2 6
 (HP) (yield gpm)

Chick
 (type power)

(7) electric log No
 (yes or no)

DEPT. OF NATURAL RESOURCES
 BUREAU OF LAND & WATER RESOURCES

AUG 14 1981

(organization running log)


(8) how well bottom plugged back wash valve

RECEIVED

DRILLERS REMARKS:

If well telescopes please sketch and show depths.

GROUND LEVEL

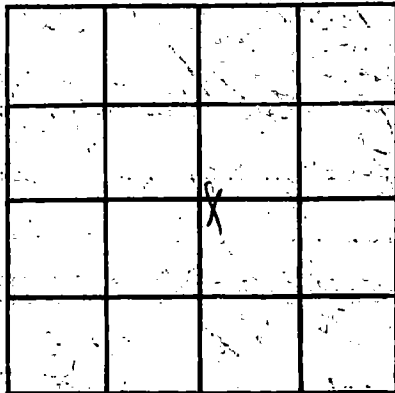

SECTION

36

Please indicate well location X.

ADDITIONAL INFORMATION

If more than one screen, show locations of each on sketch.