

MISSISSIPPI DEPARTMENT OF NATURAL RESOURCES

Bureau of Land and Water Resources

Southport Mall

P.O. Box 10631

Jackson, Mississippi 39209

WATER WELL DRILLERS LOG

JACKSON
 2147
 7-23-81

7-23-81 date well completed 81 Coash Water Well Sew. Inc. firm name Jackson county well located

LANDOWNER:

Ernest Applewhite
 P.O. Box 2115 -
 Pas. Miss. 39567
 (mailing address)

Description of formations encountered

from to

| | | |
|----------|------|------|
| Top Soil | 0 | 3' |
| A. Clay | 3' | 15' |
| C. Sand | 15' | 30' |
| G. Clay | 30' | 50' |
| C. Sand | 50' | 65' |
| B. Clay | 65' | 110' |
| C. Sand | 110' | 127' |
| B. Clay | 127' | 157' |
| M. Sand | 157' | 250' |

WELL LOCATION:

sec. 22 T. 7 N. R. 26 E.
 2 miles NW of GAUJIER
 (distance) (direction) (nearest town)

WELL PURPOSE:

(home, irrigation, municipal, industrial)

WELL COMPLETION DATA:

- (1) diameter (inches) 2"
- (2) total depth (feet) 250'
- (3) static water level (feet) 25' below top of ground
- (4) casing PVC, 240' (material) (depth)
- (5) screen 2" if telescope see back. 10' (length), 240' (depth to top)
- (6) pump 2" PVC (size) (material)
- (7) pump 1/2 HP, 9 (HP) (yield gpm)
- (8) electric (type power)
- (9) electric log No. (yes or no)

(organization running log)

(10) how well bottom plugged back wash valve

DRILLERS REMARKS:


DEPT. OF NATURAL RESOURCES
 BUREAU OF LAND & WATER RESOURCES

AUG 14 1981

RECEIVED

If well telescopes please sketch and show depths.

GROUND LEVEL

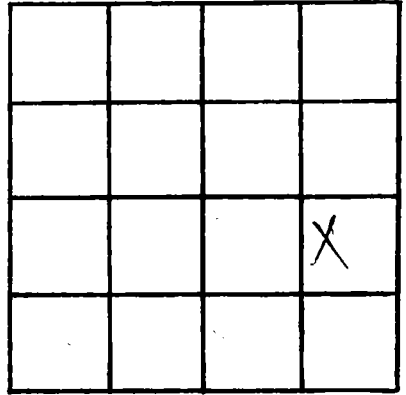

SECTION 22

Please indicate well location X.

ADDITIONAL INFORMATION

If more than one screen,
show locations of each on sketch.