

JACKSON
 Shell
 Comp # 2148
 7-23-81

MISSISSIPPI DEPARTMENT OF NATURAL RESOURCES
 Bureau of Land and Water Resources
 Southport Mall
 P.O. Box 10631
 Jackson, Mississippi 39209
WATER WELL DRILLERS LOG

7-23-1981 date well completed
 Coast Water Well Drilling firm name
 Jackson county well located

LANDOWNER: Waste Oil, Inc.
P.O. Box 330
Gautier, Miss.
 (mailing address) 39553

description of formations encountered	from	to
<u>Top soil</u>	<u>0</u>	<u>10'</u>
<u>Blue Clay</u>	<u>10'</u>	<u>194'</u>
<u>Grey Coarse sand</u>	<u>194'</u>	<u>301'</u>

WELL LOCATION:
 sec 34 T 7 N R 7 E
1/2 miles OW of GAUTIER
 (distance) (direction) (nearest town)

WELL PURPOSE: Indst.
 (home, irrigation, municipal, Industrial)

- WELL COMPLETION DATA:
- (1) diameter (inches) 2"
 - (2) total depth (feet) 301'
 - (3) static water level (feet) 24' below top of ground.
 - (4) casing PVC 291'
 (material) (depth)
2" if telescope see back.
 (size)
 - (5) screen 10' 291'
 (length) (depth to top)
2" PVC
 (size) (material)
 - (6) pump 1/2 HP 11
 (HP) (yield gpm)
Check
 (type power)
 - (7) electric log No.
 (yes or no)
- (organization running log)

(8) how well bottom plugged
Back wash valve

DRILLERS REMARKS:


DEPT. OF NATURAL RESOURCES
 BUREAU OF LAND & WATER RESOURCES

AUG 14 1981

RECEIVED

If well telescopes please sketch and show depths.

GROUND LEVEL

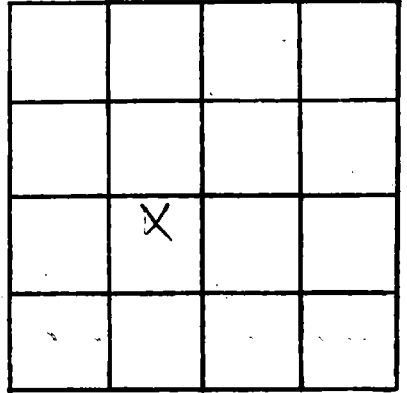

SECTION 11

Please indicate well location X.

ADDITIONAL INFORMATION

If more than one screen, show locations of each on sketch.