

MISSISSIPPI DEPARTMENT OF NATURAL RESOURCES

Bureau of Land and Water Resources

Southport Mall

P.O. Box 10631

Jackson, Mississippi 39209

WATER WELL DRILLERS LOG

JACKSON
 Φ 2149
 7-21-81

7-21-1981 date well completed
 81 Coast Water Well Service, Jackson firm name
 Jackson county well located

LANDOWNER: B.E. Meek Myrtle
 3605 Washington Ave. Sandy Top soil
 Pas. Miss. 39567 Blue Clay 55' 270'
 (mailing address)

WELL LOCATION:
 sec. 18-T-8 R-7
 6 miles SE of Ocean Springs
 (distance) (direction) (nearest town)
 Blue Clay 270' 360'
 M. Sand 360' 400'
 Note

WELL PURPOSE: Home
 (home, irrigation, municipal, industrial)

WELL COMPLETION DATA:
 (1) diameter (inches) 2"
 (2) total depth (feet) 400'
 (3) static water level (feet) 25' below top of ground.
 (4) casing PVC 390'
 (material) (depth)
 2" (size) if telescope see back.
 (5) screen 10' 390'
 (length) (depth to top)
 2" PVC (size) (material)
 (6) pump 1/2 HP 9 (yield gpm)
 Elect. (type power)
 (7) electric log No.
 (yes or no)
 (organization running log)

DEPT. OF NATURAL RESOURCES
 BUREAU OF LAND & WATER RESOURCES

AUG 14 1981


RECEIVED

(8) has well bottom plugged
 Coast Water Well Service

DRILLERS REMARKS:

If well telescopes please
sketch and show depths.

GROUND LEVEL

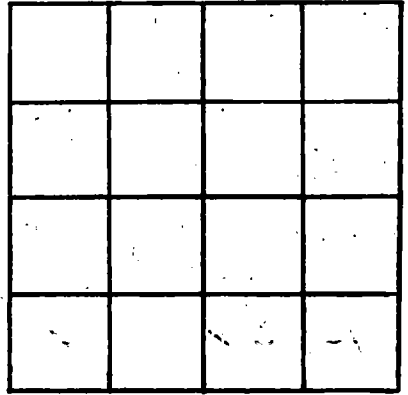

SECTION _____

Please indicate well location X.

ADDITIONAL INFORMATION

If more than one screen,
show locations of each on sketch.