

MISSISSIPPI DEPARTMENT OF NATURAL RESOURCES

Bureau of Land and Water Resources

Southport Mall

P.O. Box 10631

Jackson, Mississippi 39209

WATER WELL DRILLERS LOG

JACKSON
Φ 2151
9-21-81

9-21-81 date well completed 81 Coast Water Well Sewer. Jackson firm name county well located

LANDOWNER: Pring, Paul W.
P.O. Box 71
Gautier, Miss.
 (mailing address) 39553

Description of formations encountered	from	to
<u>Top soil</u>	<u>0</u>	<u>5'</u>
<u>Gray Clay</u>	<u>5'</u>	<u>53'</u>
<u>C. Sand</u>	<u>105'</u>	<u>105'</u>

WELL LOCATION:
 sec. 35 T. 7 S. R. 7 E.
1N miles (distance) of Gautier (direction) of (nearest town)

WELL PURPOSE: Home
 (home, irrigation, municipal, industrial)

- WELL COMPLETION DATA:
- (1) diameter (inches) 2"
 - (2) total depth (feet) 105'
 - (3) static water level (feet) 20' ^{below} _{above} top of ground.
 - (4) casing PVC (material), 100' (depth),
2" (size) if telescope see back.
 - (5) screen 5' (length), 100' (depth to top),
2" (size), PVC (material)
 - (6) pump 1/2 hp. (HP), 7- (yield gpm),
Elect. (type power)
 - (7) electric log No. (yes or no)
- (organization running log)

(8) How well bottom plugged?
Back wash valve

DRILLERS REMARKS:


DEPT. OF NATURAL RESOURCES
 BUREAU OF LAND & WATER RESOURCES

OCT 19 1981

RECEIVED

If well telescopes please sketch and show depths.

GROUND LEVEL

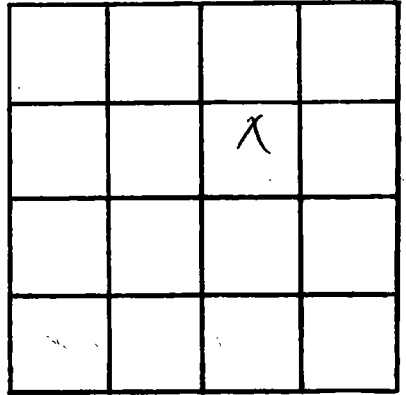

SECTION 35

Please indicate well location X.

ADDITIONAL INFORMATION

If more than one screen, show locations of each on sketch.