

MISSISSIPPI DEPARTMENT OF NATURAL RESOURCES

Bureau of Land and Water Resources

Southport Mall

P.O. Box 10631

Jackson, Mississippi 39209

WATER WELL DRILLERS LOG

JACKSON
 2152
 9-25-81

9-25-81 date well completed
 Coastal Water Well Sew. firm name
 Jackson county well located

LANDOWNER: Larry Stringer
 3912 Olferton Ave
 Passapatanz, Miss.
 (mailing address) 39567

description of formations encountered	from	to
Top soil - sand	0	2'
S. clay	2	50'
M. sand	50'	75'
		hole

WELL LOCATION:
 sec. 5 T. 8 R. 7
4 miles WSW of GAULTIER
 (distance) (direction) (nearest town)

WELL PURPOSE: Home
 (home, irrigation, municipal, industrial)

- WELL COMPLETION DATA:
- (1) diameter (inches) 2"
 - (2) total depth (feet) 75'
 - (3) static water level (feet) 18' below top of ground.
 - (4) casing PVC, 70'
 (material) (depth)
2" If telescope see back.
 (size)
 - (5) screen 5', 70'
 (length) (depth to top)
2" PVC
 (size) (material)
 - (6) pump 1/2 hp., 7
 (HP) (yield gpm)
Electric
 (type power)
 - (7) electric log No.
 (yes or no)

 (organization running log)

(8) How well bottom plugged
Back Wash Valve

DRILLERS REMARKS:


DEPT. OF NATURAL RESOURCES
 BUREAU OF LAND & WATER RESOURCES

NOV 18 1981

RECEIVED

If well telescopes please sketch and show depths.

GROUND LEVEL

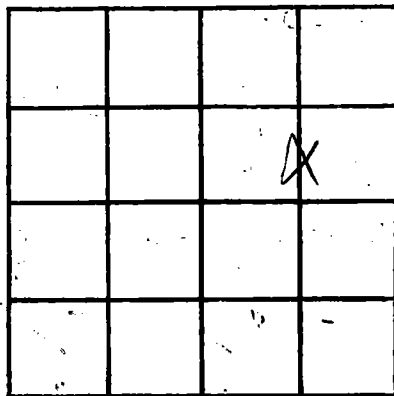

SECTION 5

Please indicate well location X.

ADDITIONAL INFORMATION

If more than one screen, show locations of each on sketch.