

MISSISSIPPI DEPARTMENT OF NATURAL RESOURCES

Bureau of Land and Water Resources

Southport Mall

P.O. Box 10631

Jackson, Mississippi 39209

WATER WELL DRILLERS LOG

JACKSON
 2153
 11-20-81

11-20-81 19 Coastal Water Well Sew. Jackson
 date well completed firm name county well located

LANDOWNER: Michael Dume
2620 Grandline Rd
Gautier, Miss 39553
 (mailing address)

description of formations encountered	from	to
<u>Top soil</u>	<u>0</u>	<u>3'</u>
<u>Blue clay</u>	<u>3'</u>	<u>11'</u>
<u>Red med sand</u>	<u>11'</u>	<u>21'</u>
<u>blue clay & clay shell</u>	<u>21'</u>	<u>44'</u>
<u>gray coarse sand</u>	<u>44'</u>	<u>84'</u>

WELL LOCATION:
 sec. R314 T 8 S 1 R 7 W
IN miles (distance) 0 (direction) of GAUTIER (nearest town)

WELL PURPOSE: Home
 (home, irrigation, municipal, industrial)

WELL COMPLETION DATA:

(1) diameter (inches) 2"

(2) total depth (feet) 84'

(3) static water level (feet) 20' below top of ground.

(4) casing PVC 74'
 (material) (depth)

2" (size) if telescope see back.

(5) screen 10' 74'
 (length) (depth to top)

2" (size) PVC (material)

(6) pump _____ (HP) _____ (yield gpm)

_____ (type power)

(7) electric log No
 (yes or no)

_____ (organization running log)

(8) how well bottom plugged Back Wash Valve

DEPT. OF NATURAL RESOURCES
 BUREAU OF LAND & WATER RESOURCES


DEC 11 1981

RECEIVED

DRILLERS REMARKS:

If well telescopes please sketch and show depths.

GROUND LEVEL

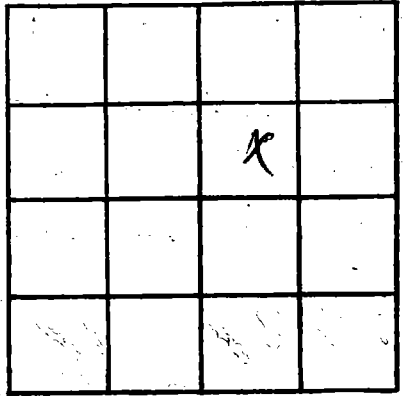

SECTION FG 14

Please indicate well location X.

ADDITIONAL INFORMATION

If more than one screen, show locations of each on sketch.