

MISSISSIPPI DEPARTMENT OF NATURAL RESOURCES

Bureau of Land and Water Resources

Southport Mall

P.O. Box 10631

Jackson, Mississippi 39209

WATER WELL DRILLERS LOG

02/55

12-381-19 date well completed  
 Coast Water Well Sew. firm name  
 Jackson county well located

LANDOWNER: Robert D. Halber  
 P.O. Box 1502  
 Pascagoula Miss.  
 (mailing address) 39567

WELL LOCATION:  
 sec. 36 T 7 N R 7 E  
 1/4 miles (distance) of GAULTIER (nearest town)

WELL PURPOSE: home  
 (home, irrigation, municipal, industrial)

WELL COMPLETION DATA:  
 (1) diameter (inches) 2"  
 (2) total depth (feet) 290'  
 (3) static water level (feet) 32' below top of ground  
 (4) casing PVC 350' (material) (depth)  
 2" (size) if telescope see back.  
 (5) screen 10' 280' (length) (depth to top)  
 2" PVC (material) (size)  
 (6) pump 1 hp. 8 (HP) (yield gpm)  
 Elec. (type power)  
 (7) electric log No. (yes or no)  
 (organization running log)

description of formations encountered	from	to
Top soil	0	10'
Blue Clay	10'	50'
White Coarse sand	50'	64'
White Coarse sand & Wood.	64'	70'
White Coarse sand & gravel	70'	80'
Blue Clay	80'	86'
Blue Clay & streak of sand	86'	107'
Gray Coarse sand	107'	129'
Blue Clay & streak of sand	129'	213'
Gray Coarse sand	213'	290'
		Hole

(8) how well bottom plugged  
 Pack work value

DRILLERS REMARKS:


DEPT. OF NATURAL RESOURCES  
 BUREAU OF LAND & WATER RESOURCES

JAN 26 1982

RECEIVED

If well telescopes please sketch and show depths.

GROUND LEVEL

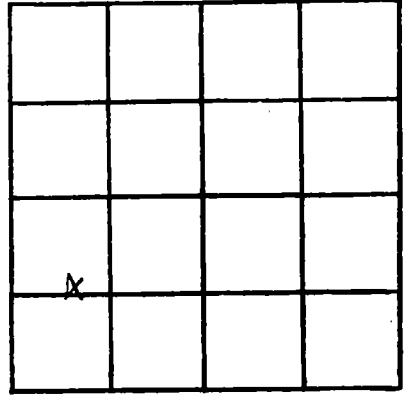

SECTION 36

Please indicate well location X.

ADDITIONAL INFORMATION

If more than one screen, show locations of each on sketch.