

MISSISSIPPI DEPARTMENT OF NATURAL RESOURCES

Bureau of Land and Water Resources

Southport Mall Mississippi State Office Building

P.O. Box 10631

Jackson, Mississippi 39209

WATER WELL DRILLERS LOG

Jackson
02/15/82

2-26th
date well completed

821 Cash Water Well Sew.
firm name

Jackson
county well located

LANDOWNER:

Elizabeth McMiller

description of formations encountered

from to

Gen. Del.
Gautier, Miss 39533
(mailing address)

Sand Top soil

0 10'

WELL LOCATION:

sec. 14 T. 8 N. R. 7 E.
1 N miles (distance) of GAUTIER (nearest town)

S. Clay

10' 60'

S. Sand

60' 75'

WELL PURPOSE:

Home
(home, irrigation, municipal, industrial)

WELL COMPLETION DATA:

- (1) diameter (inches) 2"
- (2) total depth (feet) 75'
- (3) static water level (feet) 20' below top of ground
- (4) casing PVC 65'
(material) (depth)
2" (size) if telescope see back.
- (5) screen 10' 65'
(length) (depth to top)
2" (size) PVC (material)
- (6) pump 1/2 7
(HP) (yield-gpm)
Elect. (type power)
- (7) electric log No.
(yes or no)

(organization running log)

(8) how well bottom plugged
Back work Value

DRILLERS REMARKS:


DEPT. OF NATURAL RESOURCES
BUREAU OF LAND & WATER RESOURCES

MAR 11 1982

RECEIVED

If well telescopes please sketch and show depths.

GROUND LEVEL

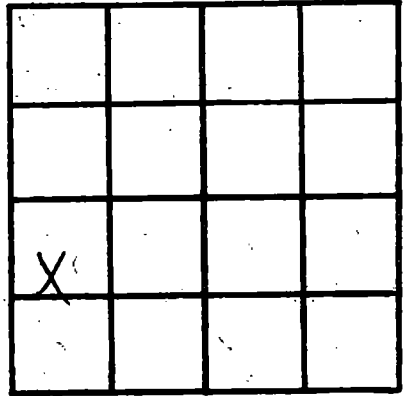

SECTION 14

Please indicate well location X.

ADDITIONAL INFORMATION

If more than one screen,
show locations of each on sketch.