

MISSISSIPPI DEPARTMENT OF NATURAL RESOURCES

Bureau of Land and Water Resources

Southport Mall

P.O. Box 10631

Jackson, Mississippi 39209

WATER WELL DRILLERS LOG

Jackson
02158

3-12-82 19 Coast Water Well Sew. Jackson
date well completed firm name county well located

LANDOWNER: Sam Myr Cohen
P.O. Box 836
Gautier Miss.
(mailing address)

description of formations encountered	from to	
<u>Top soil</u>	<u>0</u>	<u>5'</u>
<u>Red Clay</u>	<u>5'</u>	<u>14'</u>
<u>C. sand</u>	<u>14'</u>	<u>27'</u>
<u>Blue Clay</u>	<u>27'</u>	<u>55'</u>
<u>C. sand</u>	<u>55'</u>	<u>70'</u>
		<u>hole</u>

WELL LOCATION:
sec 34 T 7 S R 7 E
2 miles W of GAUTIER
(distance) (direction) (nearest town)

WELL PURPOSE:
(home, irrigation, municipal, industrial)

WELL COMPLETION DATA:

(1) diameter (Inches) 8 1/2"

(2) total depth (feet) 70'

(3) static water level (feet) 30 below top of ground. above

(4) casing PVC 60'
(material) (depth)
2" If telescope see back.
(size)

(5) screen 10' 60'
(length) (depth to top)
2" PVC
(size) (material)

(6) pump 1 9
(HP) (yield gpm)
Elect.
(type power)

(7) electric log No.
(yes or no)

(organization running log)

(*) how well bottom plugged
Back Wash Valve

DRILLERS REMARKS:


DEPT. OF NATURAL RESOURCES
BUREAU OF LAND & WATER RESOURCES

APR 1982

RECORDED

If well telescopes please sketch and show depths.

GROUND LEVEL

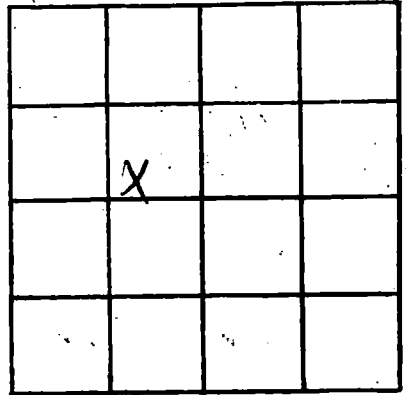

SECTION 34

Please indicate well location X.

ADDITIONAL INFORMATION

If more than one screen, show locations of each on sketch.