

MISSISSIPPI DEPARTMENT OF NATURAL RESOURCES

Bureau of Land and Water Resources

Southport Mall

P.O. Box 10631

Jackson, Mississippi 39209

WATER WELL DRILLERS LOG

Jackson
02159

3-10-82

19 Coast Water Well Sew. Jackson

date well completed

firm name

county well located

LANDOWNER

Elmy E. May
3004 Bernis
Gautier, Miss.
(mailing address) 39533

description of formations encountered

from to

Sandy Topsoil	0	15'
B. Clay	15'	35'
C. Sand	35'	85'
B. Clay	85'	93'
C. Sand	93'	112'
B. Clay	112'	120'
C. Sand	120'	210'
B. Clay	210'	225'
M.C. Sand	225'	298'

WELL LOCATION:

sec 36 T 76 R 76
10 miles (distance) of GAUTIER (direction) of (nearest town)

WELL PURPOSE:

(home, irrigation, municipal, industrial) Home

WELL COMPLETION DATA:

- (1) diameter (inches) 2"
- (2) total depth (feet) 300'
- (3) static water level (feet) 25' below top of ground
- (4) casing PVC 290' (material) (depth)
- (5) screen 2" (size) 10' (length) 290' (depth to top)
- (6) pump 1 hp (HPV) 8 1/2 (yield gpm)
- (7) electric log (type power) No. (yes or no)

(organization running log)

(8) How well bottom plugged back wash valve

DRILLERS REMARKS:


DEPT. OF NATURAL RESOURCES
BUREAU OF LAND & WATER RESOURCES

APR 20 1982

REC

If well telescopes please sketch and show depths.

GROUND LEVEL

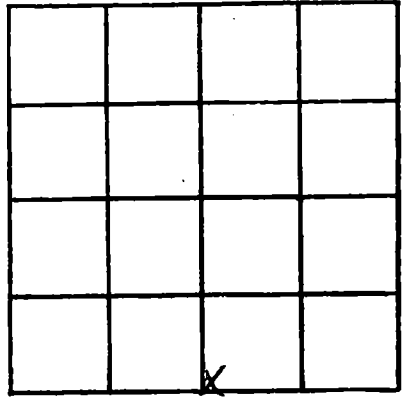

SECTION 36

Please indicate well location X.

ADDITIONAL INFORMATION

If more than one screen,
show locations of each on sketch.