

MISSISSIPPI DEPARTMENT OF NATURAL RESOURCES

Bureau of Land and Water Resources

Southport Mall

P.O. Box 10631

Jackson, Mississippi 39209

WATER WELL DRILLERS LOG

Jackson
02160

3-25-82 19 date well completed
Coast Water Well Sew. firm name
Jackson county well located

LANDOWNER: Mike Dunn
Pascazulay
Missi. 39567
(mailing address)

WELL LOCATION:
sec. 19 T. 8 N. R. 7 W.
4 miles SW of BRANTON
(distance) (direction) (nearest town)

WELL PURPOSE: none
(home, irrigation, municipal, industrial)

WELL COMPLETION DATA:
(1) diameter (inches) 2"
(2) total depth (feet) 327'
(3) static water level (feet) 25' below top of ground.
(4) casing PVC 317' (material) (depth)
2" (size) if telescope see back.
(5) screen 10' 317' (length) (depth to top)
2" PVC (size) (material)
(6) pump 1 hp 9 (HP) (yield gpm)
Elex. (type power)
(7) electric log No. (yes or no)
(organization running log)
(8) how well bottom plugged Backwash Valve

description of formations encountered	from	to
Top soil	0	1'
White coarse sand and wood	1'	40'
White coarse sand	40'	76'
Blue Clay & streak of sand	76'	86'
White coarse sand	86'	105'
Blue Clay	105'	191'
Gray med. sand	191'	212'
Blue Clay	212'	230'
Blue Clay & streak of sand	230'	294'
Six inches Rock	294'	
Blue Clay	294'	306'
Gray coarse sand	306'	327'

DEPT. OF NATURAL RESOURCES
BUREAU OF LAND & WATER RESOURCES


MAY 10 1982

RECEIVED

DRILLERS REMARKS:

If well telescopes please sketch and show depths.

GROUND LEVEL

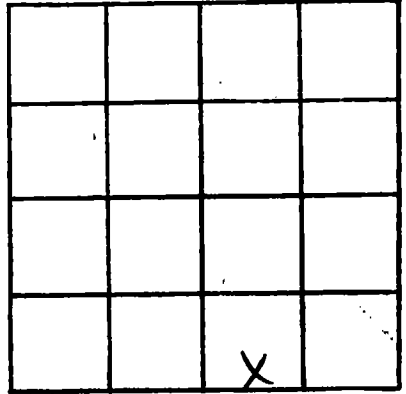

SECTION 19

Please indicate well location X.

ADDITIONAL INFORMATION

If more than one screen, show locations of each on sketch.