

MISSISSIPPI DEPARTMENT OF NATURAL RESOURCES

Bureau of Land and Water Resources

Southport Mall

P.O. Box 10631

Jackson, Mississippi 39209

WATER WELL DRILLERS LOG

Jackson
02462

5-6-82
date well completed

Coast & Water Well Sew.
firm name

Jackson
county well located

LANDOWNER: D. D. Peacock
Anchor 1. Park
Lot # 72 1600 Highway 90
Gautier, Miss. 39553
(mailing address)

description of formations encountered	from	to
Sandy Top soil	0	5'
D. Clay	5'	50'
C. Sand	50'	160'
B. Clay	160'	186'
C. Sand	186'	270'

WELL LOCATION:

sec 36 T 7 N R 7 E
IN miles _____ of GAULTIER
(distance) (direction) (nearest town)

WELL PURPOSE: Home
(home, irrigation, municipal, industrial)

WELL COMPLETION DATA:

- (1) diameter (inches) 2"
- (2) total depth (feet) 270'
- (3) static water level (feet) 45' ^{below} ~~above~~ top of ground.
- (4) casing PVC 260'
(material) (depth)
2" If telescope see back.
(size)
- (5) screen 10' 260'
(length) (depth to top)
2" PVC
(size) (material)
- (6) pump 1 hp. 8
(HP) (yield gpm)
Elect.
(type power)
- (7) electric log No.
(yes or no)

(organization running log)
- (8) how well bottom plugged: back wash valve

DEPT. OF NATURAL RESOURCES
BUREAU OF LAND & WATER RESOURCES


JUN - 4 1982

RECEIVED

DRILLERS REMARKS:

If well telescopes please sketch and show depths.

GROUND LEVEL

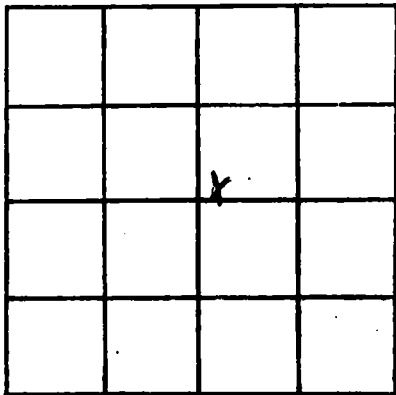

SECTION 36

Please indicate well location X.

ADDITIONAL INFORMATION

If more than one screen,
show locations of each on sketch.