

MISSISSIPPI DEPARTMENT OF NATURAL RESOURCES

Bureau of Land and Water Resources

Southport Mall

P.O. Box 10631

Jackson, Mississippi 39209

WATER WELL DRILLERS LOG

Jackson
02164

5-20-82 19 Coast Water Well Sew. Jackson
date well completed firm name county well located

LANDOWNER: Louis Brown

3209 Smith Dr.
Gautier, Miss.
(mailing address)

description of formations encountered

from to

<u>Top soil</u>	<u>0</u>	<u>2'</u>
<u>IV Clay</u>	<u>2</u>	<u>56'</u>
<u>A. sand</u>	<u>56'</u>	<u>75'</u>
<u>B. Clay</u>	<u>75'</u>	<u>98'</u>
<u>C. sand</u>	<u>98'</u>	<u>125'</u>
<u>B. Clay</u>	<u>125'</u>	<u>146'</u>
<u>C. sand</u>	<u>146'</u>	<u>178'</u>
<u>B. Clay</u>	<u>178'</u>	<u>196'</u>
<u>C. sand</u>	<u>196'</u>	<u>300'</u>
		<u>None</u>

WELL LOCATION:

sec 36 T 7 R 7 E
1N miles (distance) of SOUTHERN (direction) of GAUTIER (nearest town)

WELL PURPOSE:

Home
(home, irrigation, municipal, industrial)

WELL COMPLETION DATA:

- (1) diameter (inches) 2"
- (2) total depth (feet) 300'
- (3) static water level (feet) 25' ^{below} _{above} top of ground.
- (4) casing PVC 290'
(material) (depth)
- 2"
(size) if telescope see back.
- (5) screen 10' 290'
(length) (depth to top)
- 2" PVC
(size) (material)
- (6) pump 1K.P. 9
(HP) (yield gpm)
- blue
(type power)
- (7) electric log No.
(yes or no)

(organization running log)

(8) how well bottom plugged back work blue

DRILLERS REMARKS:


DEPT. OF NATURAL RESOURCES
BUREAU OF LAND & WATER RESOURCES

JUN - 4 1982

RECEIVED

If well telescopes please sketch and show depths.

GROUND LEVEL

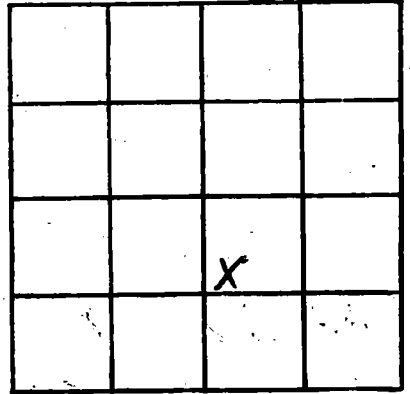

SECTION 36

Please indicate well location X.

ADDITIONAL INFORMATION

If more than one screen, show locations of each on sketch.

A handwritten mark resembling a stylized '7' or a checkmark, located in the lower portion of the 'ADDITIONAL INFORMATION' section.