

Jackson
 02167

MISSISSIPPI DEPARTMENT OF NATURAL RESOURCES
 Bureau of Land and Water Resources
 Southport Mall
 P.O. Box 10631

Jackson, Mississippi 39209
 WATER WELL DRILLERS LOG

6-14-82 19 Coast Water Well Sew. Jackson
 date well completed firm name county well located

LANDOWNER: W. K. Penton
Old Spanish Tr.
Gautier, Miss.
 (mailing address) 39533

WELL LOCATION:
 sec. 36 T. 7 N. R. 7 E.
1 miles (distance) W (direction) of GAUTIER (nearest town)

WELL PURPOSE: Home
 (home, irrigation, municipal, industrial)

WELL COMPLETION DATA:
 (1) diameter (inches) 2"
 (2) total depth (feet) 291'
 (3) static water level (feet) 30' below top of ground. above
 (4) casing PVC, 281' (material), (depth), 2" (size) if telescope see back.
 (5) screen 10', 281' (length), (depth to top), 2" (size), PVC (material)
 (6) pump 1 hp., 8 (HP), (yield gpm), Electric (type power)
 (7) electric log No (yes or no)
— (organization running log)
 (8) how well bottom plugged Back Wash Valve

description of formations encountered	from	to
Top soil	0	3'
S. Clay	3	30'
C. Sand	30'	70'
S. Clay	70'	94'
C. Sand and P. gravel	94'	179'
B. Clay	179'	210'
C. sand	210'	291'

DEPT. OF NATURAL RESOURCES
 BUREAU OF LAND & WATER RESOURCES


JUL 21 1982

RECEIVED

DRILLERS REMARKS:

If well telescopes please sketch and show depths.

GROUND LEVEL

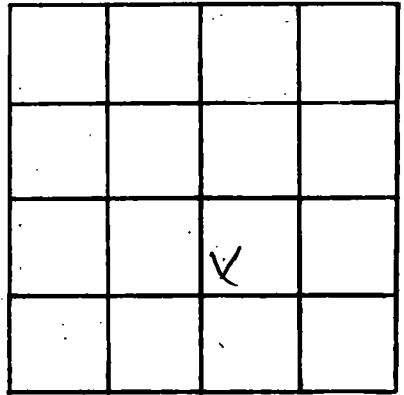

SECTION 36

Please indicate well location X.

ADDITIONAL INFORMATION

If more than one screen,
show locations of each on sketch.