

**MISSISSIPPI
BOARD OF WATER COMMISSIONERS
416 North State Street
Jackson, Mississippi 39201**

WATER WELL DRILLERS LOG

Jackson
02168

6/25 19*82* *Cecil S. Hordell* *Jackson*
date well completed well firm name county well located

LANDOWNER: *Wallace Parker*
Perkinston Miss

description of formations encountered	from	to
<i>Soft Soil</i>	<i>0</i>	<i>7</i>
<i>Red Soil</i>	<i>2</i>	<i>6</i>
<i>Red Clay</i>	<i>6</i>	<i>15</i>
<i>Sand Gravel</i>	<i>15</i>	<i>40</i>
<i>Blue Clay</i>	<i>40</i>	<i>105</i>
<i>Sdk Sand</i>	<i>105</i>	<i>117</i>
<i>Blue clay</i>	<i>117</i>	<i>251</i>
<i>Sand</i>	<i>251</i>	<i>273</i>

(mailing address)

WELL LOCATION:

sec. *17* *N* *7* *E*
7 miles *S* of *Vandue*
(distance) (direction) (nearest town)

WELL PURPOSE: *Home*
(home, irrigation, municipal, industrial)

WELL COMPLETION DATA:

- (1) diameter (inches) *2"*
- (2) total depth (feet) *273*
- (3) static water level (feet) *0* below above *100*
top of ground
- (4) casing *Plastic, 273*
(material) (depth)
- if telescope see back.
- (5) screen *to 268 263*
(length) (depth to top)
- 2"* *Plastic*
(size) (material)
- (6) pump *20*
(HP) (yield gpm)
- (type power)
- (7) electric log _____
(yes or no)

(organization running log)
(8) how well bottom plugged *Back Wash valve*

DRILLERS REMARKS:


DEPT. OF NATURAL RESOURCES
BUREAU OF LAND & WATER RESOURCES

JUL 27 1982

RECEIVED

If well telescopes please sketch and show depths.

GROUND LEVEL

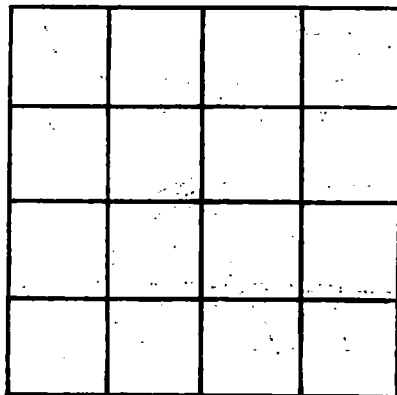

SECTION _____

Please indicate well location X.

ADDITIONAL INFORMATION

If more than one screen, show locations of each on sketch.