

MISSISSIPPI DEPARTMENT OF NATURAL RESOURCES

Bureau of Land and Water Resources

Southport Mall

P.O. Box 10631

Jackson, Mississippi 39209

WATER WELL DRILLERS LOG
COASTAL DRILLING & SERVICE CO.

Jackson
02169

6/25/82 19
date well completed

ROUTE 1 BOX 618
firm name

Jackson
county well located

BILOXI, MISS. 39532

LANDOWNER: Wesley

description of formations encountered

from to

Seaholm Red

Top Soil

1 3

Sartorius MS

Red Clay

3 15

(mailing address)

White Sand

15 35

WELL LOCATION:

Soft Blue Clay

35 230

sec. 20 T. 7 R. 7

Shell

230 235

2 1/2 mi North of Monticello
(distance) (direction) (nearest town)

Light Water Sand

235 270

WELL PURPOSE:

home

(home, irrigation, municipal, industrial)

Dark Blue Clay

270 310

WELL COMPLETION DATA:

fine water sand

310 460

(1) diameter (inches)

2"

Good water sand

460 500

(2) total depth (feet)

500'

(3) static water level (feet)

35' ^{below} _{above}

top of ground.

(4) casing

PVC 490'
(material) (depth)

(size) If telescope see back.

(5) screen

10' 490'
(length) (depth to top)

(size)

2" PVC
(material)

(6) pump

None 12
(HP) (yield gpm)

(type power)

(7) electric log

no
(yes or no)

(organization running log)

(8) have well bottom plugged

2 1/2 mi North of Monticello

DRILLERS REMARKS:

19-B


DEPT. OF NATURAL RESOURCES
BUREAU OF LAND & WATER RESOURCES

DEC - 1 1982

RECEIVED

If well telescopes please sketch and show depths.

GROUND LEVEL

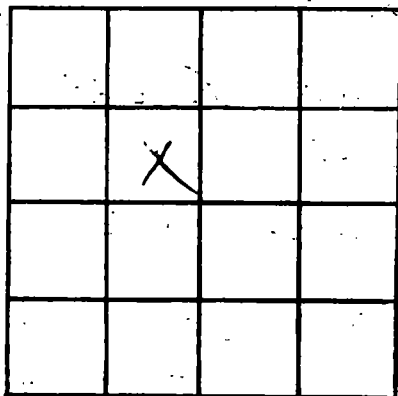

SECTION _____

Please indicate well location X.

ADDITIONAL INFORMATION

If more than one screen, show locations of each on sketch.