

MISSISSIPPI DEPARTMENT OF NATURAL RESOURCES

Bureau of Land and Water Resources

Southport Mall

P.O. Box 10631

Jackson, Mississippi 39209

WATER WELL DRILLERS LOG

Jackson
02470

6-28-82 19 Coast Water Well Sewer Jackson
date well completed firm name county well located

LANDOWNER: John Wilton
Rt 3- Box 286
Ocean Springs, Miss.
(mailing address) 39064

description of formations encountered	from	to
Top soil	0	2'
Red Coarse sand	2'	22'
Blue Clay	22'	40'
White Coarse sand	40'	83'

WELL LOCATION:
sec. 31 T. 7 N. R. 7 E.
3 1/2 miles ESE of Ocean Springs
(distance) (direction) (nearest town)

WELL PURPOSE: Home
(home, irrigation, municipal, industrial)

WELL COMPLETION DATA:

- (1) diameter (inches) 2"
- (2) total depth (feet) 83
- (3) static water level (feet) 25 ^{below} top of ground
- (4) casing PVC, 73' CL
(material) (depth)
- 2"
(size) If telescope see back.
- (5) screen 10', 73'
(length) (depth to top)
- 2", PVC
(size) (material)
- (6) pump 1/2, 8
(HP) (yield gpm)
- Electric
(type power)
- (7) electric log No
(yes or no)
- _____
(organization running log)
- (8) how well bottom plugged Back wash Valve

DRILLERS REMARKS:


DEPT. OF NATURAL RESOURCES
BUREAU OF LAND & WATER RESOURCES

JUL 21 1982

RECEIVED

If well telescopes please sketch and show depths.

GROUND LEVEL

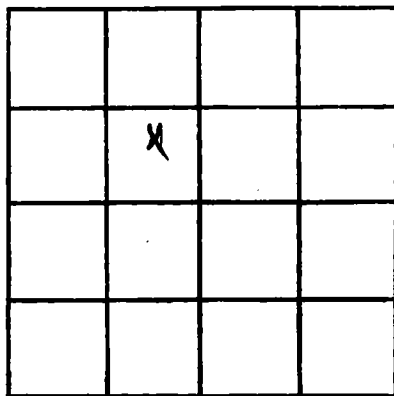

SECTION 31

Please indicate well location X.

ADDITIONAL INFORMATION

If more than one screen,
show locations of each on sketch.