

MISSISSIPPI DEPARTMENT OF NATURAL RESOURCES

Bureau of Land and Water Resources

Southport Mall

P.O. Box 10631

Jackson, Mississippi 39209

WATER WELL DRILLERS LOG

Jackson
D 211

7-14 82 19
date well completed

Coast Water Well Sew. Jackson
firm name county well located

LANDOWNER: Arthur Sunday
4825 Old Spanish Trail
Gautier, Miss.
(mailing address) 39553

WELL LOCATION:
sec. 33 T 7 S R 8 E
2 1/2 miles SW of GAUTIER
(distance) (direction) (nearest town)

WELL PURPOSE: Water
(home, irrigation, municipal, industrial)

WELL COMPLETION DATA:
(1) diameter (inches) 2"
(2) total depth (feet) 300'
(3) static water level (feet) 25' ^{below} ~~above~~ top of ground.
(4) casing PVC 290' ^u
(material) (depth)
5" (size) If telescope see back.
(5) screen 10' 290'
(length) (depth to top)
2" PVC
(size) (material)
(6) pump 1/2 HP 8
(type power) (yield gpm)
Electric
(7) electric log No.
(yes or no)
(organization running log)

Description of formations encountered	from	to
Top soil	0	2'
Red Clay	2'	10'
Blue Clay & Sphalerite	10'	47'
Gray Coarse sand & gravel	47'	73'
Blue Clay	73'	117'
Blue Clay & Sphalerite	117'	160'
Blue Clay	160'	300'
Gray Coarse sand	300'	300'

DEPT. OF NATURAL RESOURCES
BUREAU OF LAND & WATER RESOURCES

SEP - 1 1982


RECEIVED

(8) how well bottom plugged
Back wash Valve

DRILLERS REMARKS:

If well telescopes please sketch and show depths.

GROUND LEVEL

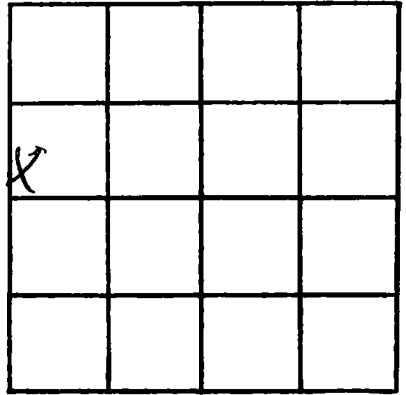

SECTION 33

Please indicate well location X.

ADDITIONAL INFORMATION

If more than one screen, show locations of each on sketch.