

MISSISSIPPI DEPARTMENT OF NATURAL RESOURCES

Bureau of Land and Water Resources

Southport Mall

P.O. Box 10631

Jackson, Mississippi 39209

WATER WELL DRILLERS LOG

Jackson
0 2172

7-13

82 Coast Water Well Sew. Jackson

date well completed

firm name

county well located

LANDOWNER: Kenne Byrd

description of formations encountered

from to

Mass Point, Miss
3713 Touris St.
(mailing address)

Sandy Top soil

0 15'

B. Clay

15' 74'

C. sand

74' 85'
161c

WELL LOCATION:

sec. 9 T. 8 R. 7
3 miles SW of GAULTIER
(distance) (direction) (nearest town)

WELL PURPOSE: home
(home, irrigation, municipal, industrial)

WELL COMPLETION DATA:

- (1) diameter (inches) 2"
- (2) total depth (feet) 85'
- (3) static water level (feet) 22' (below top of ground)
- (4) casing PVC, 80'
(material) (depth)
- 2"
(size) if telescope see back.
- (5) screen 5', 80'
(length) (depth to top)
- 2", PVC
(size) (material)
- (6) pump 3/4 hp, 5
(HP) (yield gpm)
- elec.
(type power)
- (7) electric log No.
(yes or no)
- (organization running log)

DEPT. OF NATURAL RESOURCES
BUREAU OF LAND & WATER RESOURCES

SEP - 1 1982


RECEIVED

(8) how well bottom plugged back with valve

DRILLERS REMARKS:

If well telescopes please sketch and show depths.

GROUND LEVEL

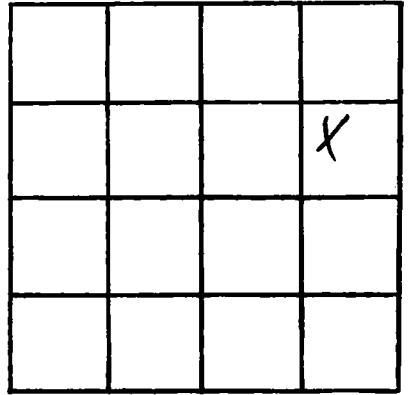

SECTION 9

Please indicate well location X.

ADDITIONAL INFORMATION

If more than one screen, show locations of each on sketch.