

MISSISSIPPI DEPARTMENT OF NATURAL RESOURCES

Bureau of Land and Water Resources

Southport Mall

P.O. Box 10631

Jackson, Mississippi 39209

WATER WELL DRILLERS LOG

Jackson  
02173

8-4-82 date well completed 82 Coast Water Well Serv. firm name Jackson county well located

LANDOWNER:

Howard D. Davis

description of formations encountered

from

to

Box 143 HH -  
Ocean Springs, Miss.  
(mailing address) 39564

Top soil	0	5'
Red clay	5'	10'
Blue clay	10'	130'
Gray coarse sand	130'	180'
Blue clay	180'	210'
Gray coarse sand	210'	234'
Blue clay	234'	382'
Gray coarse sand	382'	451'

WELL LOCATION:

sec. 8 T. 7 N. R. 7 E.  
5 miles NW of GAUTIER  
(distance) (direction) (nearest town)

WELL PURPOSE:

Home (home, irrigation, municipal, industrial)

WELL COMPLETION DATA:

- (1) diameter (inches) 5"
- (2) total depth (feet) 451'
- (3) static water level (feet) 48' below above top of ground.
- (4) casing PVC (material), 441' (depth)  
5" (size) if telescope see back.
- (5) screen 10' (length), 441' (depth to top)  
2" (size), PVC (material)
- (6) pump (HP) (yield gpm)  
Elect. (type power)
- (7) electric log No. (yes or no)  
(organization running log)

(8) how well bottom plugged? Back Wash Valve

DRILLERS REMARKS:


DEPT. OF NATURAL RESOURCES  
BUREAU OF LAND & WATER RESOURCES

SEP 30 1982

RECEIVED

If well telescopes please sketch and show depths.

GROUND LEVEL

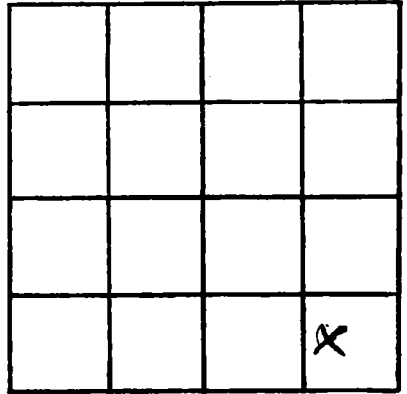

SECTION 8

Please indicate well location X.

ADDITIONAL INFORMATION

If more than one screen, show locations of each on sketch.